

This drawing is the property of IPS Architects and copyright is reserved by them.
This drawing is not to be copied or disclosed by or to any unauthorized person without the prior written consent of IPS Architects.



Do not scale from this drawing.

All dimensions are to be checked on site prior to construction, manufacture of any components and ordering of materials and equipment.


Any discrepancies are to be reported to the architects for clarification.

All materials and workmanship to be accordance with the current British Standards and codes of practice.


This drawing is to be read in conjunction with all relevant Architectural Structural Engineers, Mechanical Engineers, Electrical Engineers and Specialists drawings and specifications.

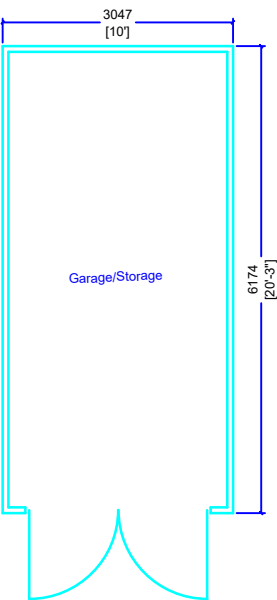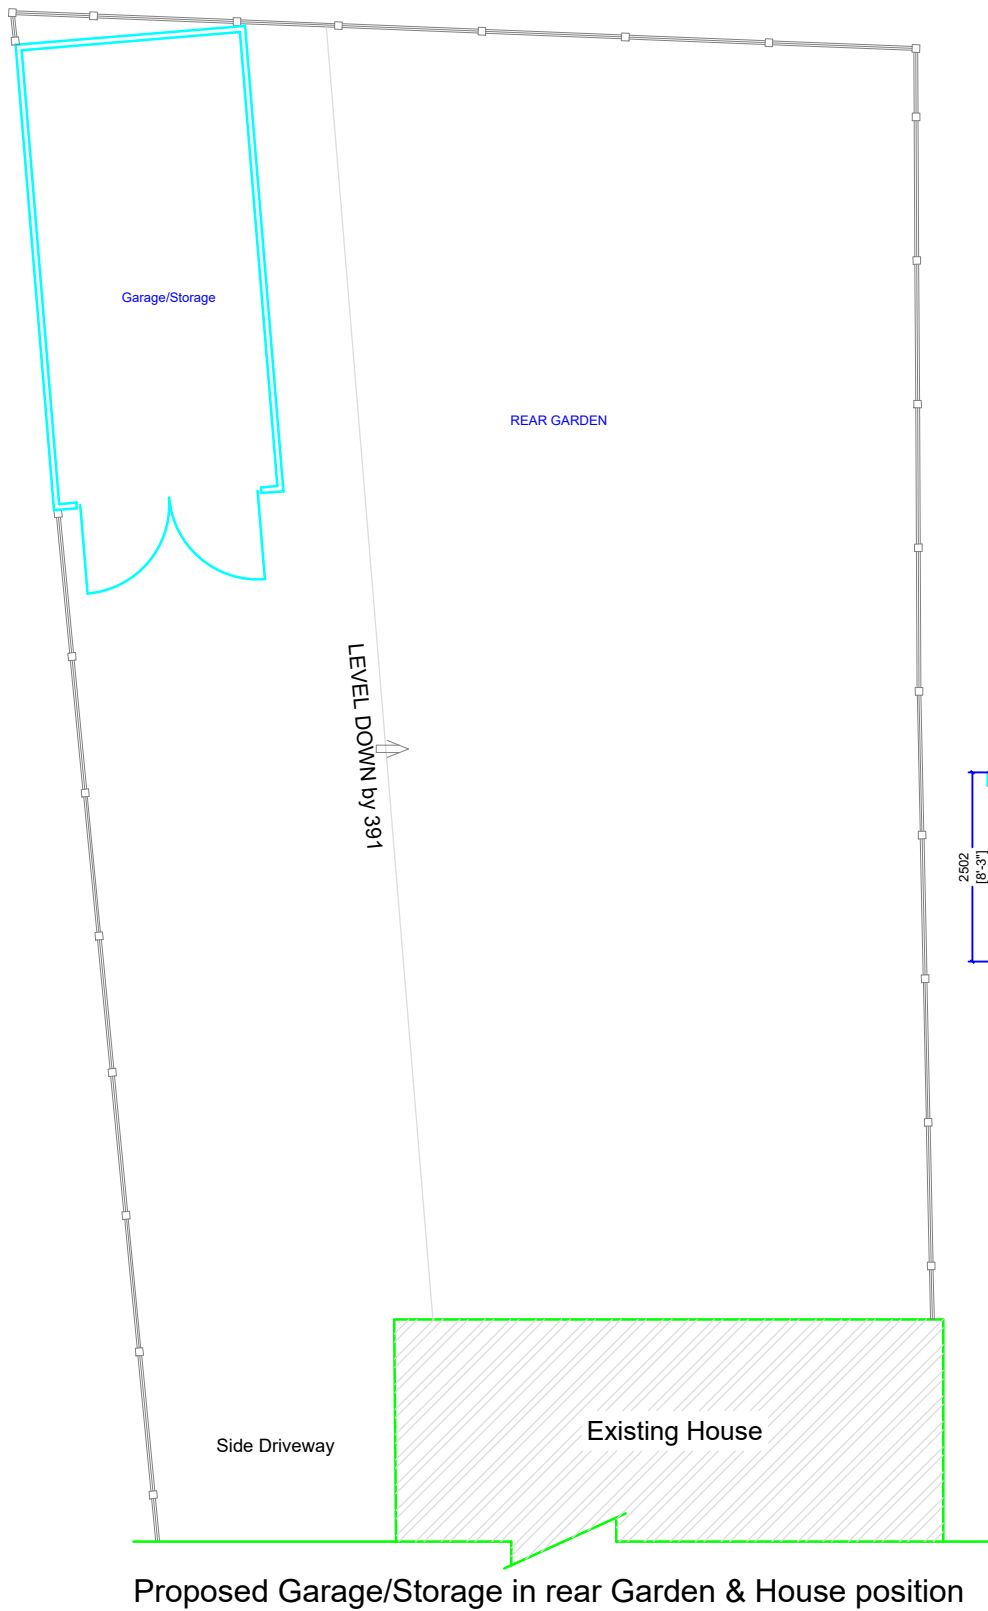


As-Built Floor Plan

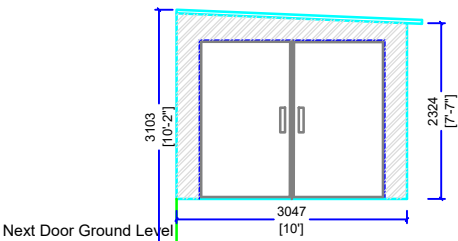

As-Built Front Elevation

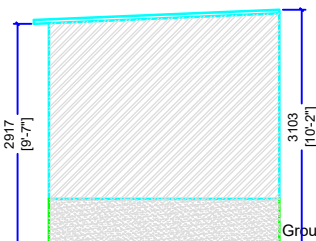

As-Built Rear Elevation

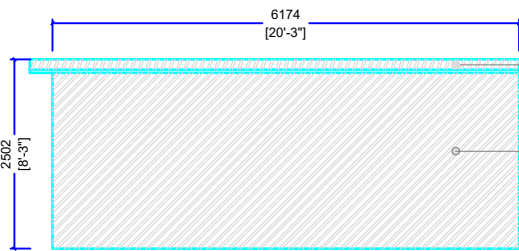


As-Built Side Elevation (North West)

Galvanized Roof Sheets

Galvanized Metal Sheets

Retaining Wall

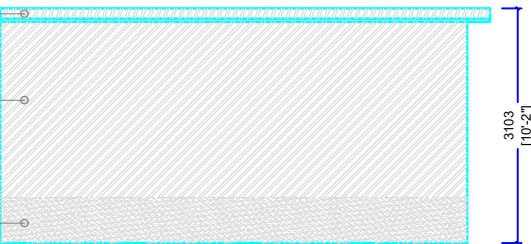

As-Built Side Elevation (South East)



Front Photograph



Side Photograph (North West)



North Corner Photograph

I Planning Services

email: ipsuk@live.co.uk

6b Cook Street,
Bury, Lancashire,
BL9 0RP,
0161 8717405

AS-Built Rear Garden, Location and Block Plans
of 7 Parrenthorn road, Prestwich, M25 2RH

Scale : 1 : 100 on A3

All Dimensions in Meters

Ref:: IPS/R/07/M252RH

Date : 22/09/2020

SHT 2 of 2

AS-Built