




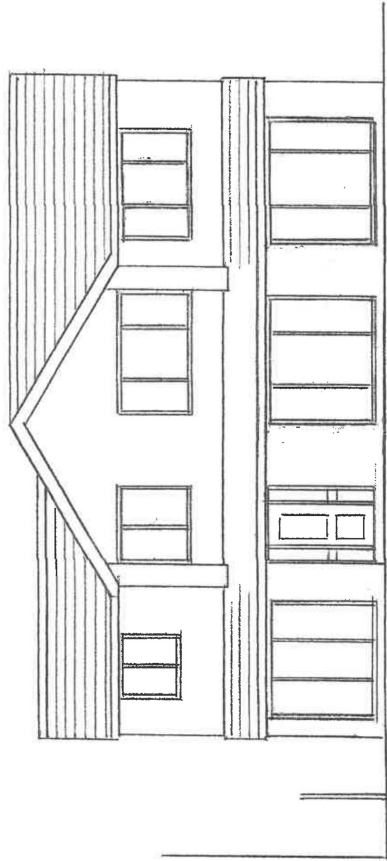


PROPOSED FRONT ELEVATION

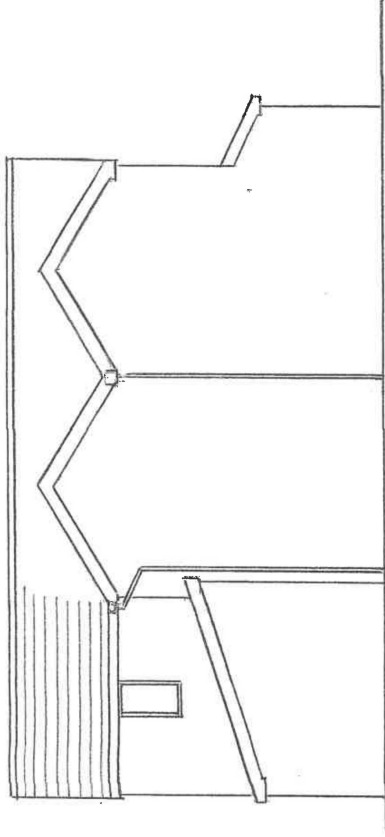

PROPOSED SIDE ELEVATION

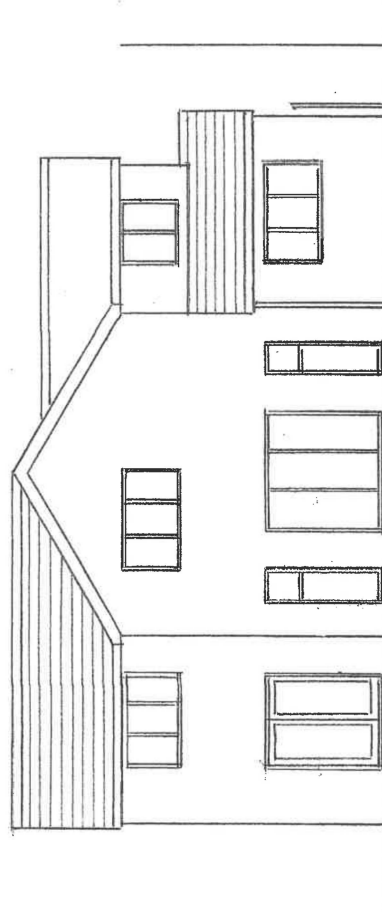

PROPOSED REAR ELEVATION

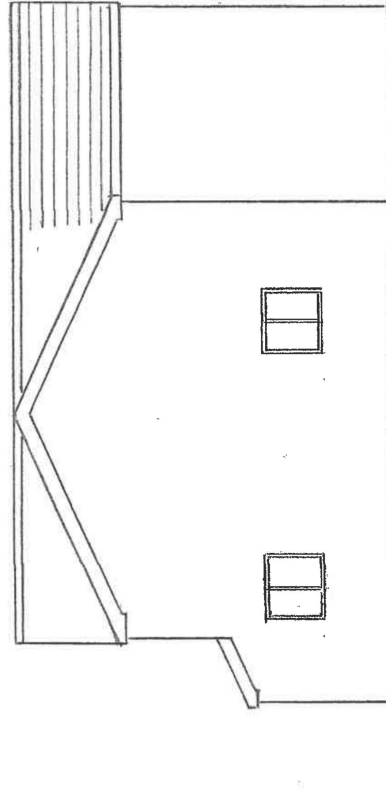

PROPOSED SIDE ELEVATION

Thompson Designs Tel 0161 705 1458 Mob 07884 318634	Sheet 3 As Built Elevations 2 Skegness Close Bury BL8 1EQ Scale 1:100 @ A3 Date July 2023
---	--

REV 1