
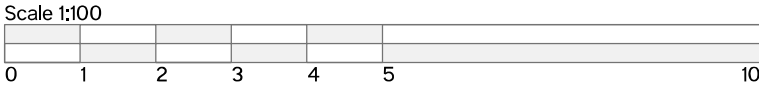


- Wet verge replaces fascia boards
- Front door centred on opening
- Window Position changed
- Altered window arrangement
- Stone gutter replaces all timber fascia boards

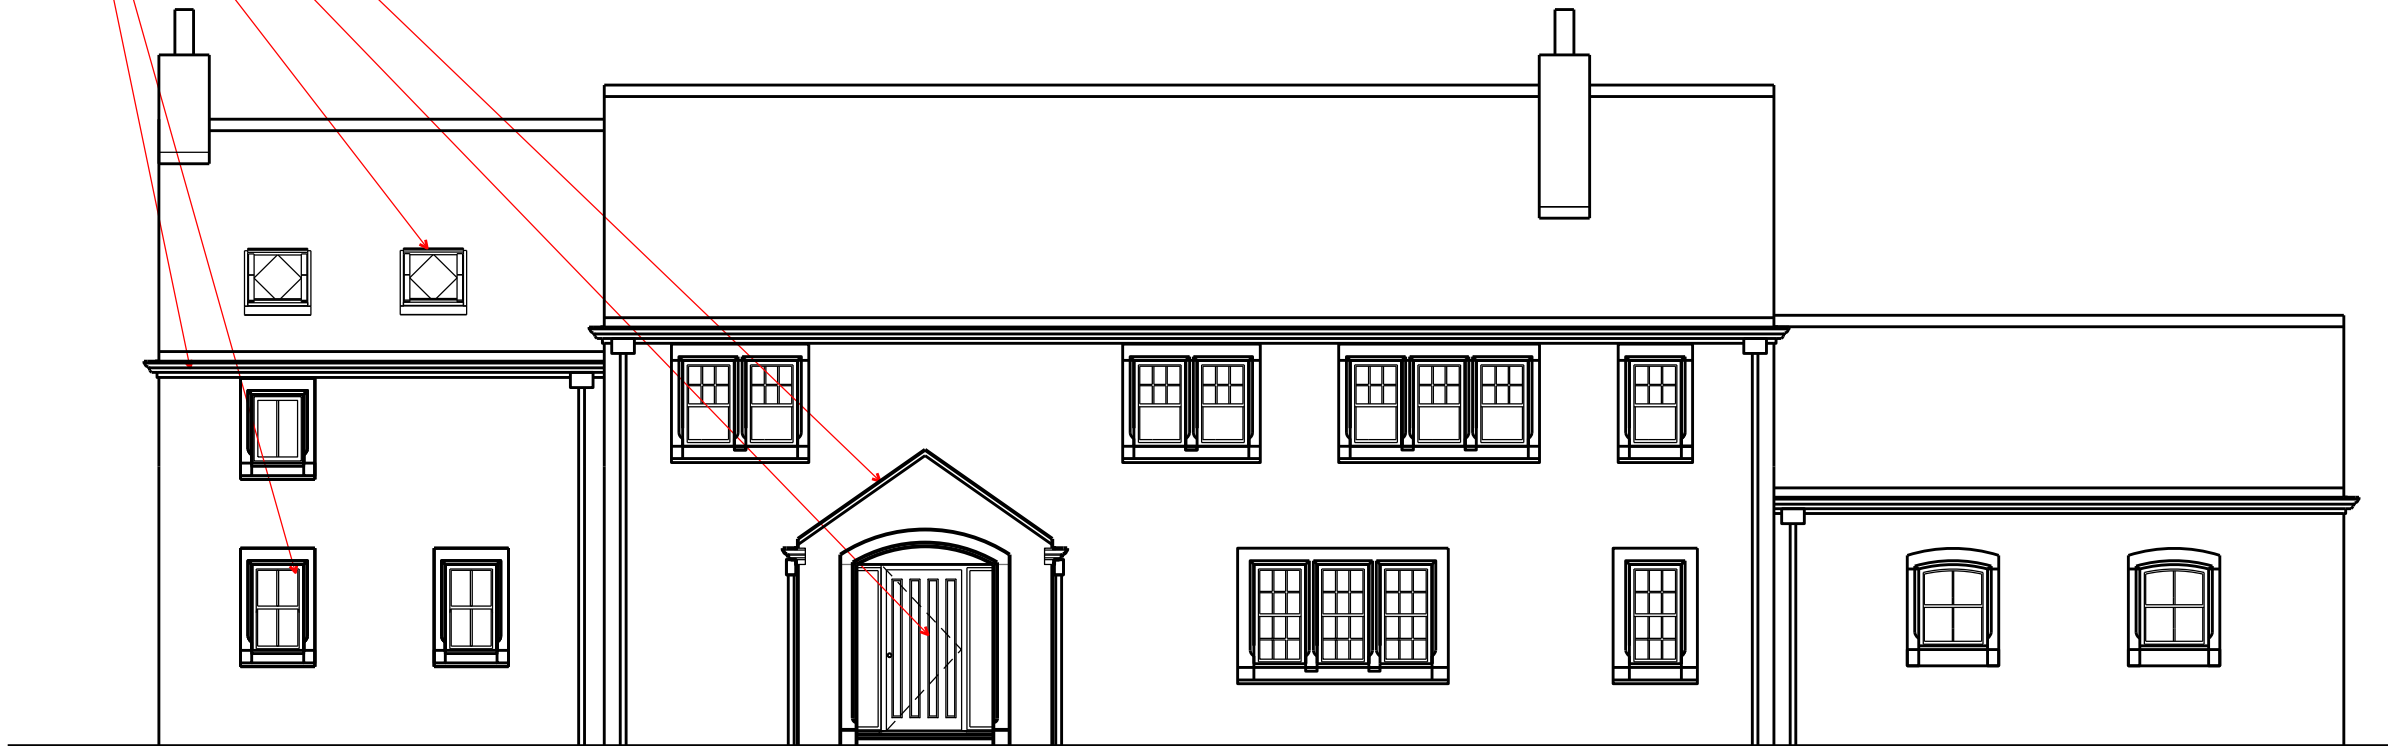

NORTHERN ARCHITECTS

11 Grosvenor Road
Altrincham
WA14 1LA
pg@northernarchitects.co.uk
+447799196215
www.northernarchitects.co.uk

Project
Ferns Farm
Tottington

Project No.
NA-2510

Revisions

Rev	Description	By	Date

Notes:

Drawing Title
Front (South) Elevation
as Proposed_Mark Up

Scale	Date	Status
1:100 @ A3	Sept 25	03

NA (-4) 001

This drawing is the exclusive copyright of Northern Architects Limited and remains under the ownership of the company. Reproduction, sharing, or copying of this drawing without prior written consent is strictly prohibited.
Adhere to all dimensions as indicated. It is essential to verify all dimensions on-site before proceeding with construction or manufacturing.