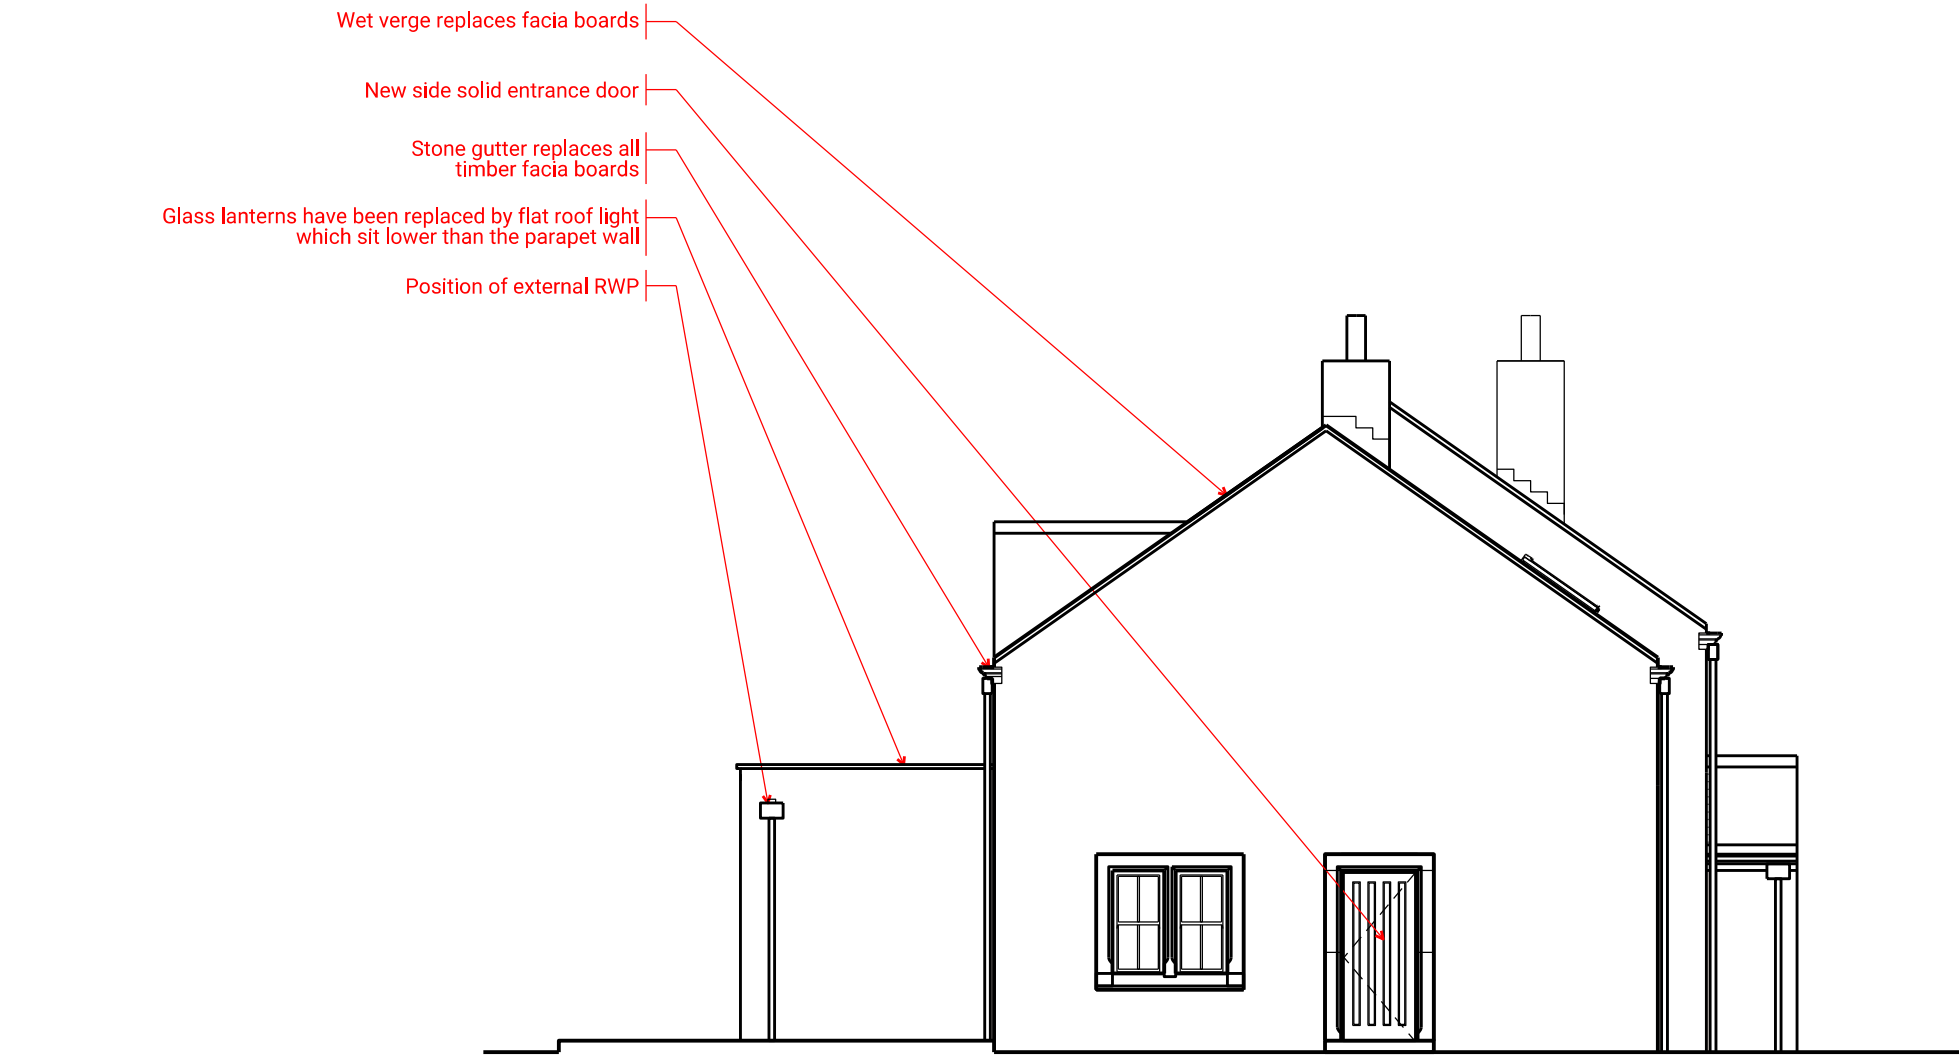


NORTHERN ARCHITECTS

11 Grosvenor Road
Altrincham
WA14 1LA
pg@northernarchitects.co.uk
+447799196215
www.northernarchitects.co.uk

Project

Ferns Farm
Tottington

Project No.

NA-2510

Revisions

Rev	Description	By	Date

Notes:

Drawing Title

Side (West) Elevation
as Proposed_Mark up

Scale Date Status
1:100 @ A3 Nov 25 03

NA (-4) 011

This drawing is the exclusive copyright of Northern Architects Limited and remains under the ownership of the company. Reproduction, sharing, or copying of this drawing without prior written consent is strictly prohibited.
Adhere to all dimensions as indicated. It is essential to verify all dimensions on-site before proceeding with construction or manufacturing.