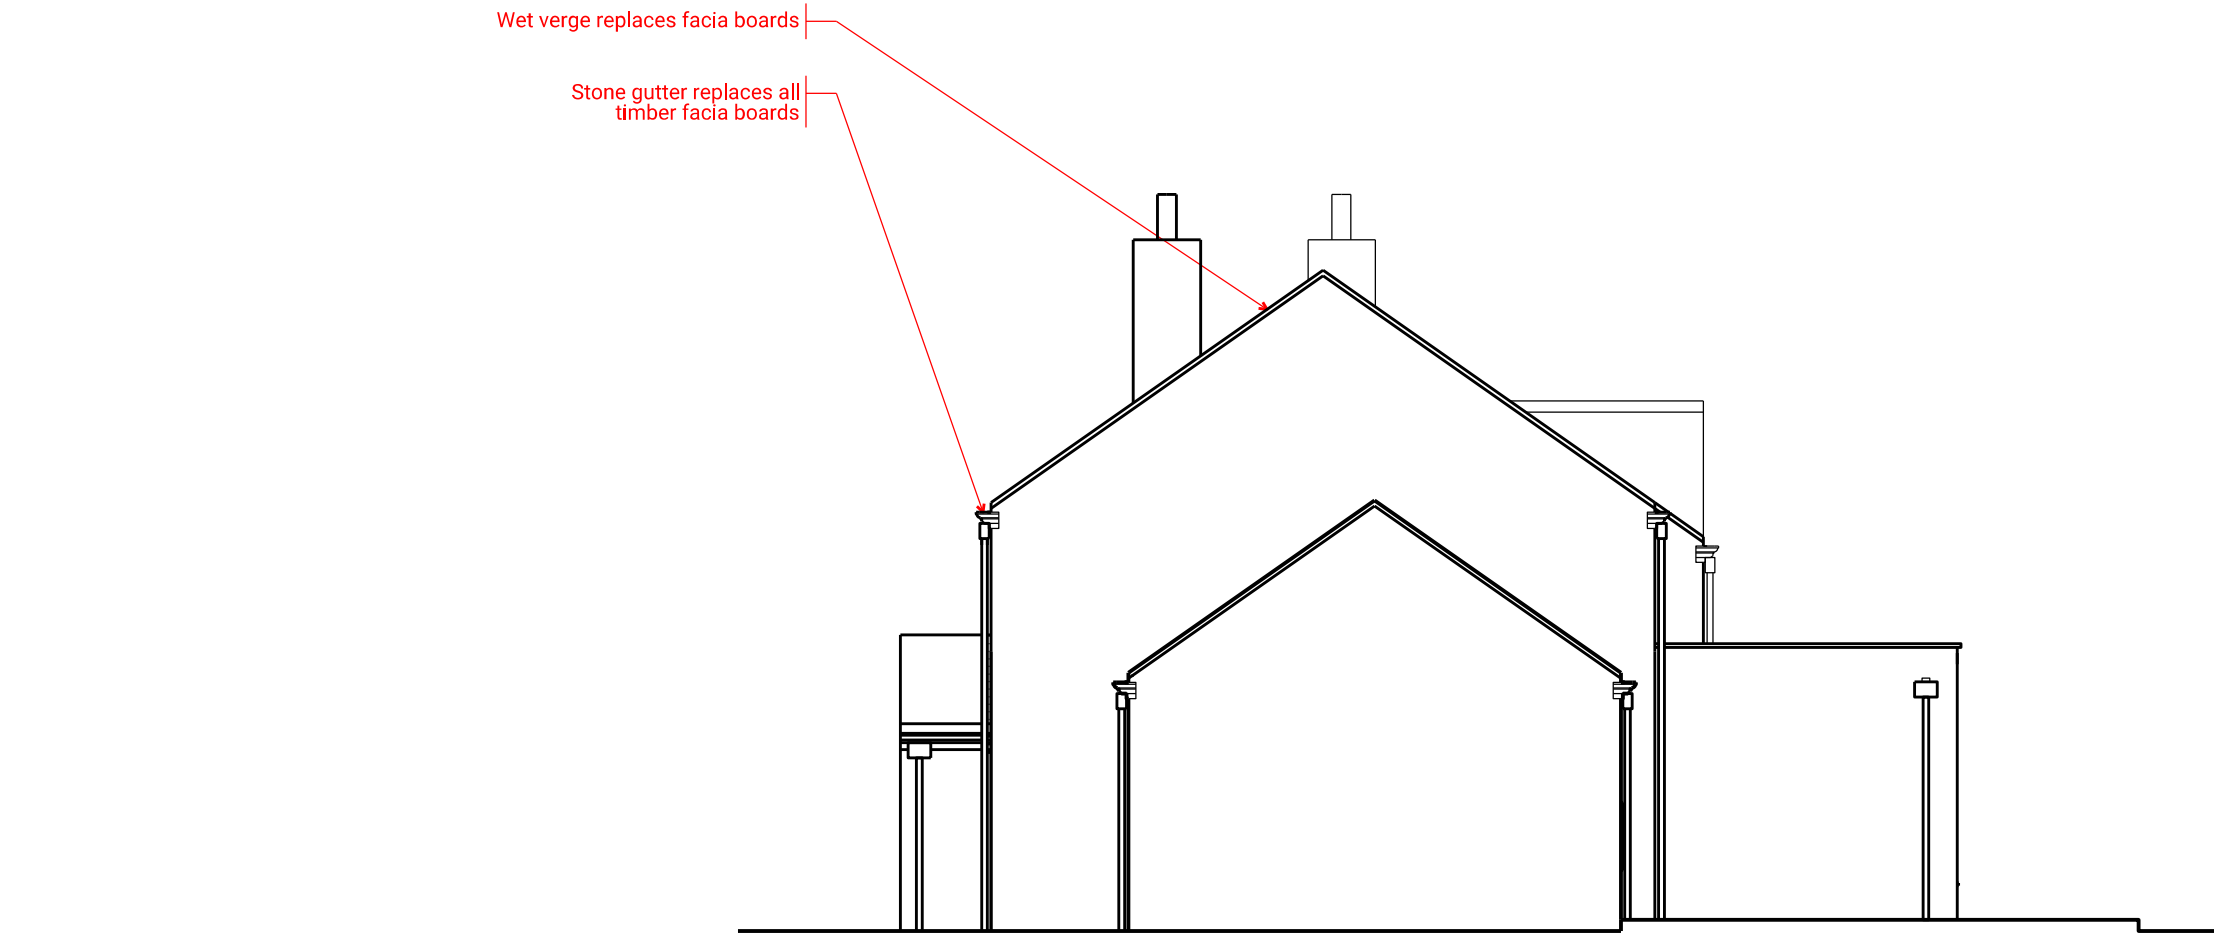


NORTHERN ARCHITECTS

11 Grosvenor Road  
Altrincham  
WA14 1LA  
pg@northernarchitects.co.uk  
+447799196215  
www.northernarchitects.co.uk

Project  
Ferns Farm  
Tottington

Project No.  
NA-2510

Revisions

| Rev | Description | By | Date |
|-----|-------------|----|------|
|     |             |    |      |
|     |             |    |      |
|     |             |    |      |
|     |             |    |      |

Notes:

Drawing Title  
Side (East) Elevation  
as Proposed\_Mark Up

Scale                      Date                      Status  
1:100 @ A3              Sept 25              03

NA (-4) 031

This drawing is the exclusive copyright of Northern Architects Limited and remains under the ownership of the company. Reproduction, sharing, or copying of this drawing without prior written consent is strictly prohibited.  
Adhere to all dimensions as indicated. It is essential to verify all dimensions on-site before proceeding with construction or manufacturing.