

This drawing is the property of IPS Architects and copyright is reserved by them.
This drawing is not to be copied or disclosed by or to any unauthorized person without the prior written consent of IPS Architects.


Do not scale from this drawing.

All dimensions are to be checked on site prior to construction, manufacture of any components and ordering of materials and equipment.


Any discrepancies are to be reported to the architects for clarification.

All materials and workmanship to be accordance with the current British Standards and codes of practice.


This drawing is to be read in conjunction with all relevant Architectural Structural Engineers, Mechanical Engineers, Electrical Engineers and Specialists drawings and specifications.

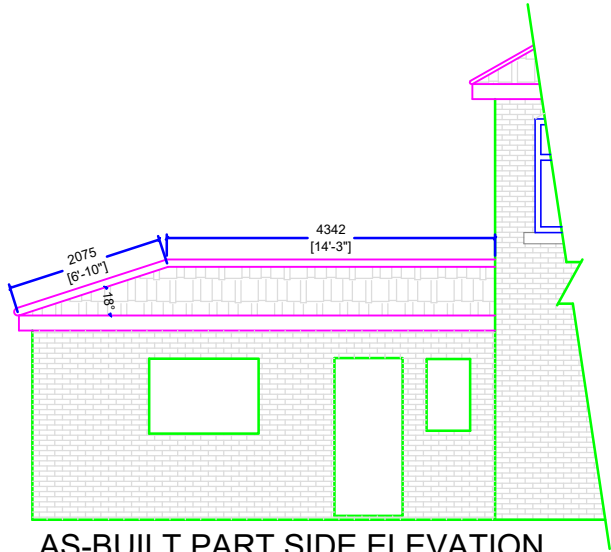


AS-BUILT PART SIDE ELEVATION
(WEST)

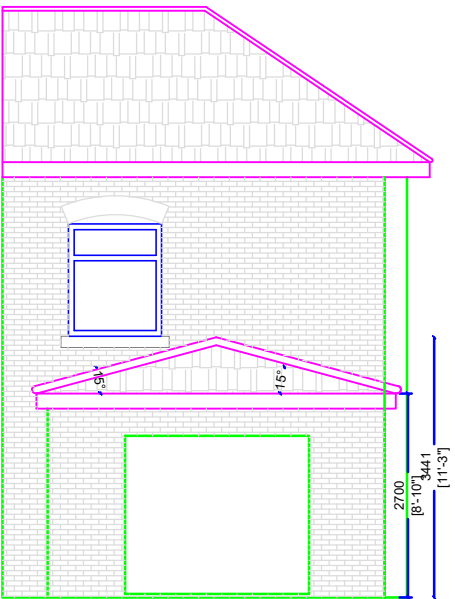

AS-BUILT REAR ELEVATION

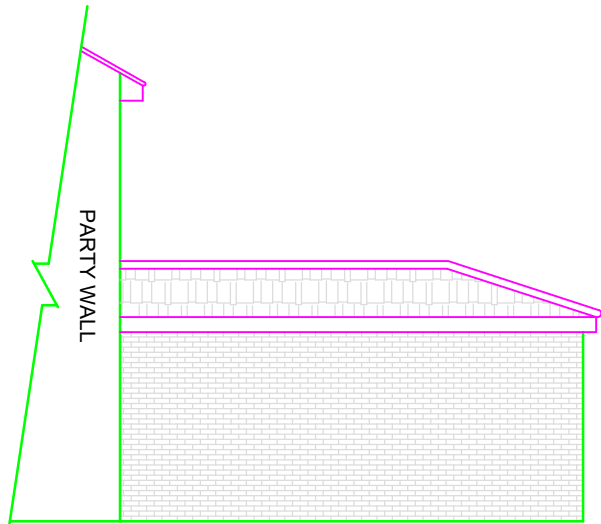


AS-BUILT PART SIDE ELEVATION
(EAST)

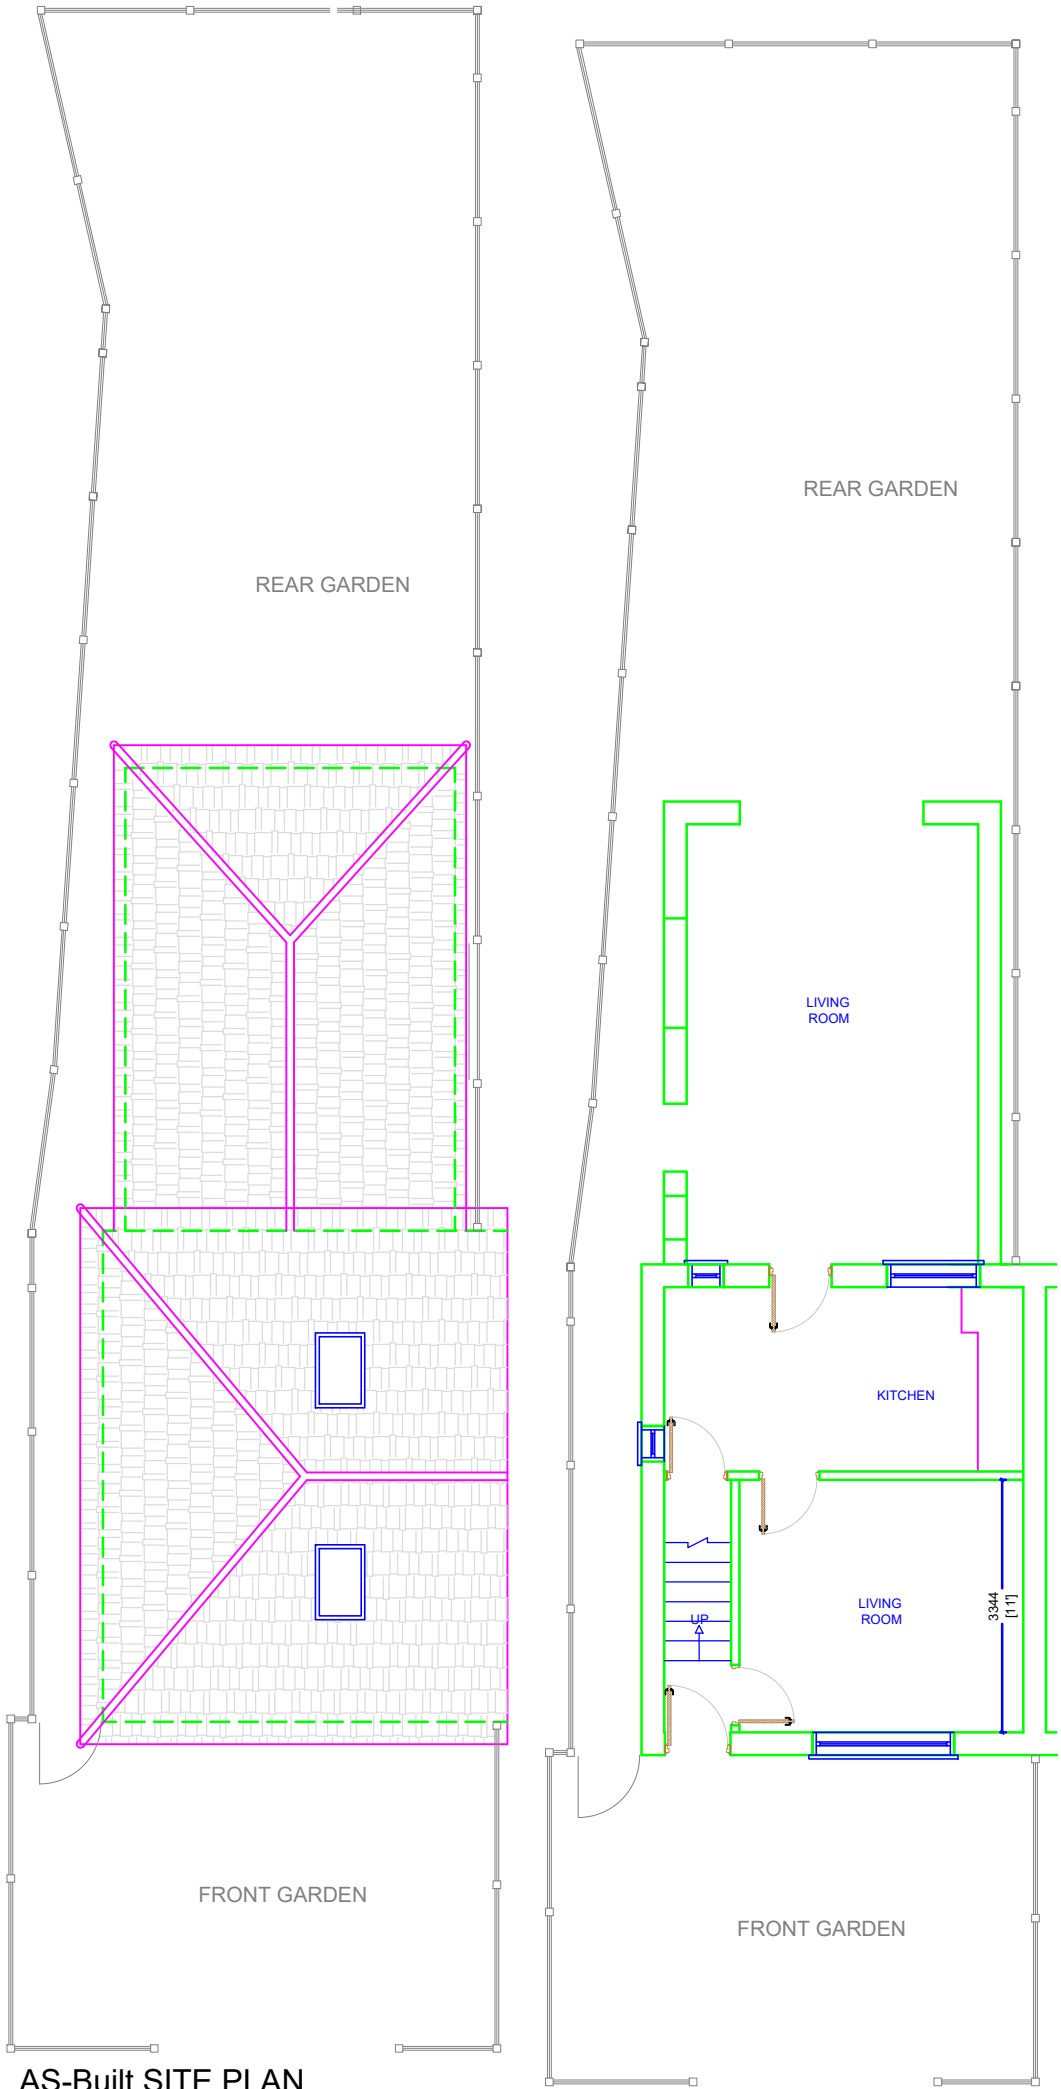


AS-Built SITE PLAN

AS-BUILT GROUND FLOOR PLAN Incl. Boundary

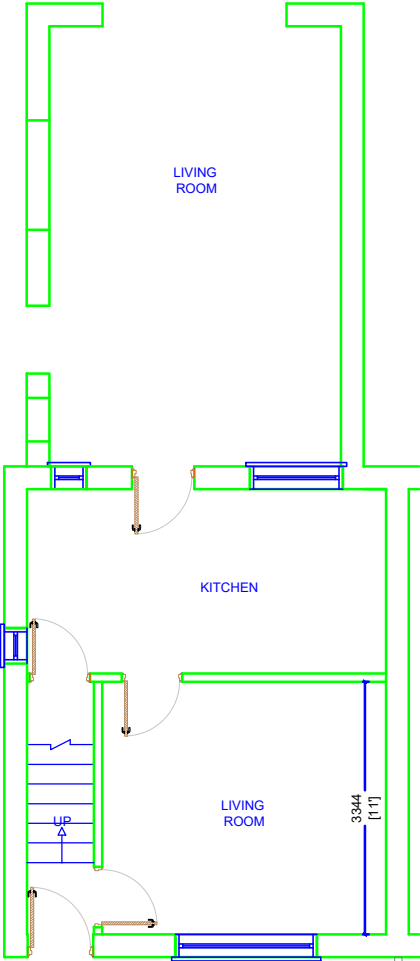

ASBUILT GROUND FLOOR PLAN

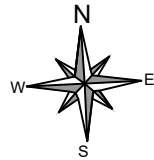

Planning Services		6b Cook Street, Bury, Lancashire, BL9 0RP, 0161 8717405	
email: ipsuk@live.co.uk			
As-Built Floor plans and Elevations of 27 Walnut Avenue, Bury, BL9 7LZ			
Scale :1 : 100 on A3		All Dimensions in Meters	
Ref.: IPS/R/27/BL97LZ		Date : 19/01/2022	
SHT 3 of 4		As-Built	

