




Proposed Side Elevation

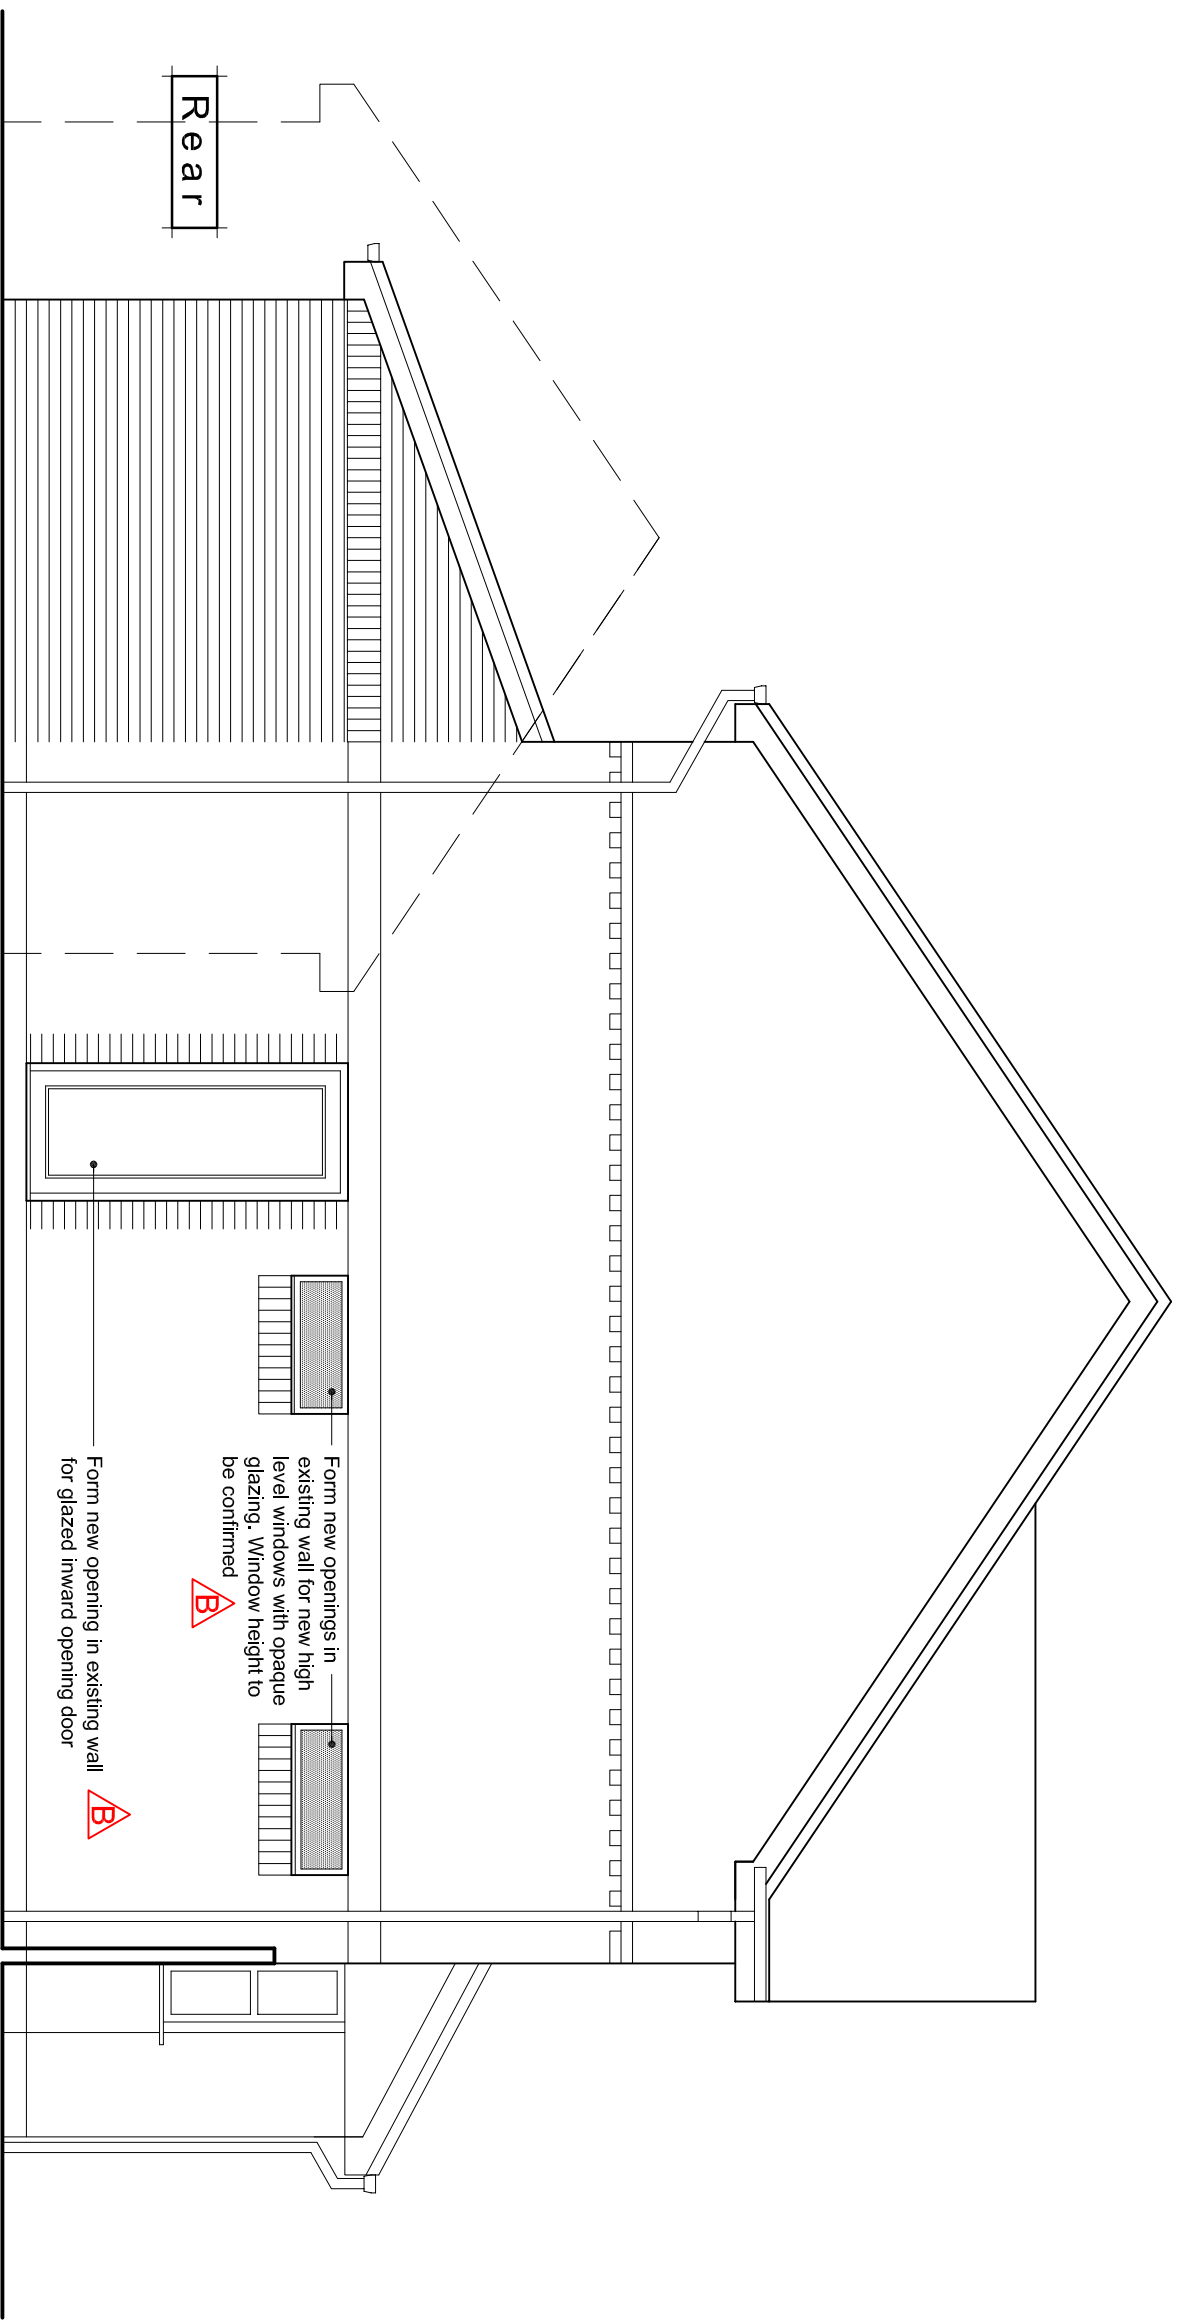

Proposed Side Elevation

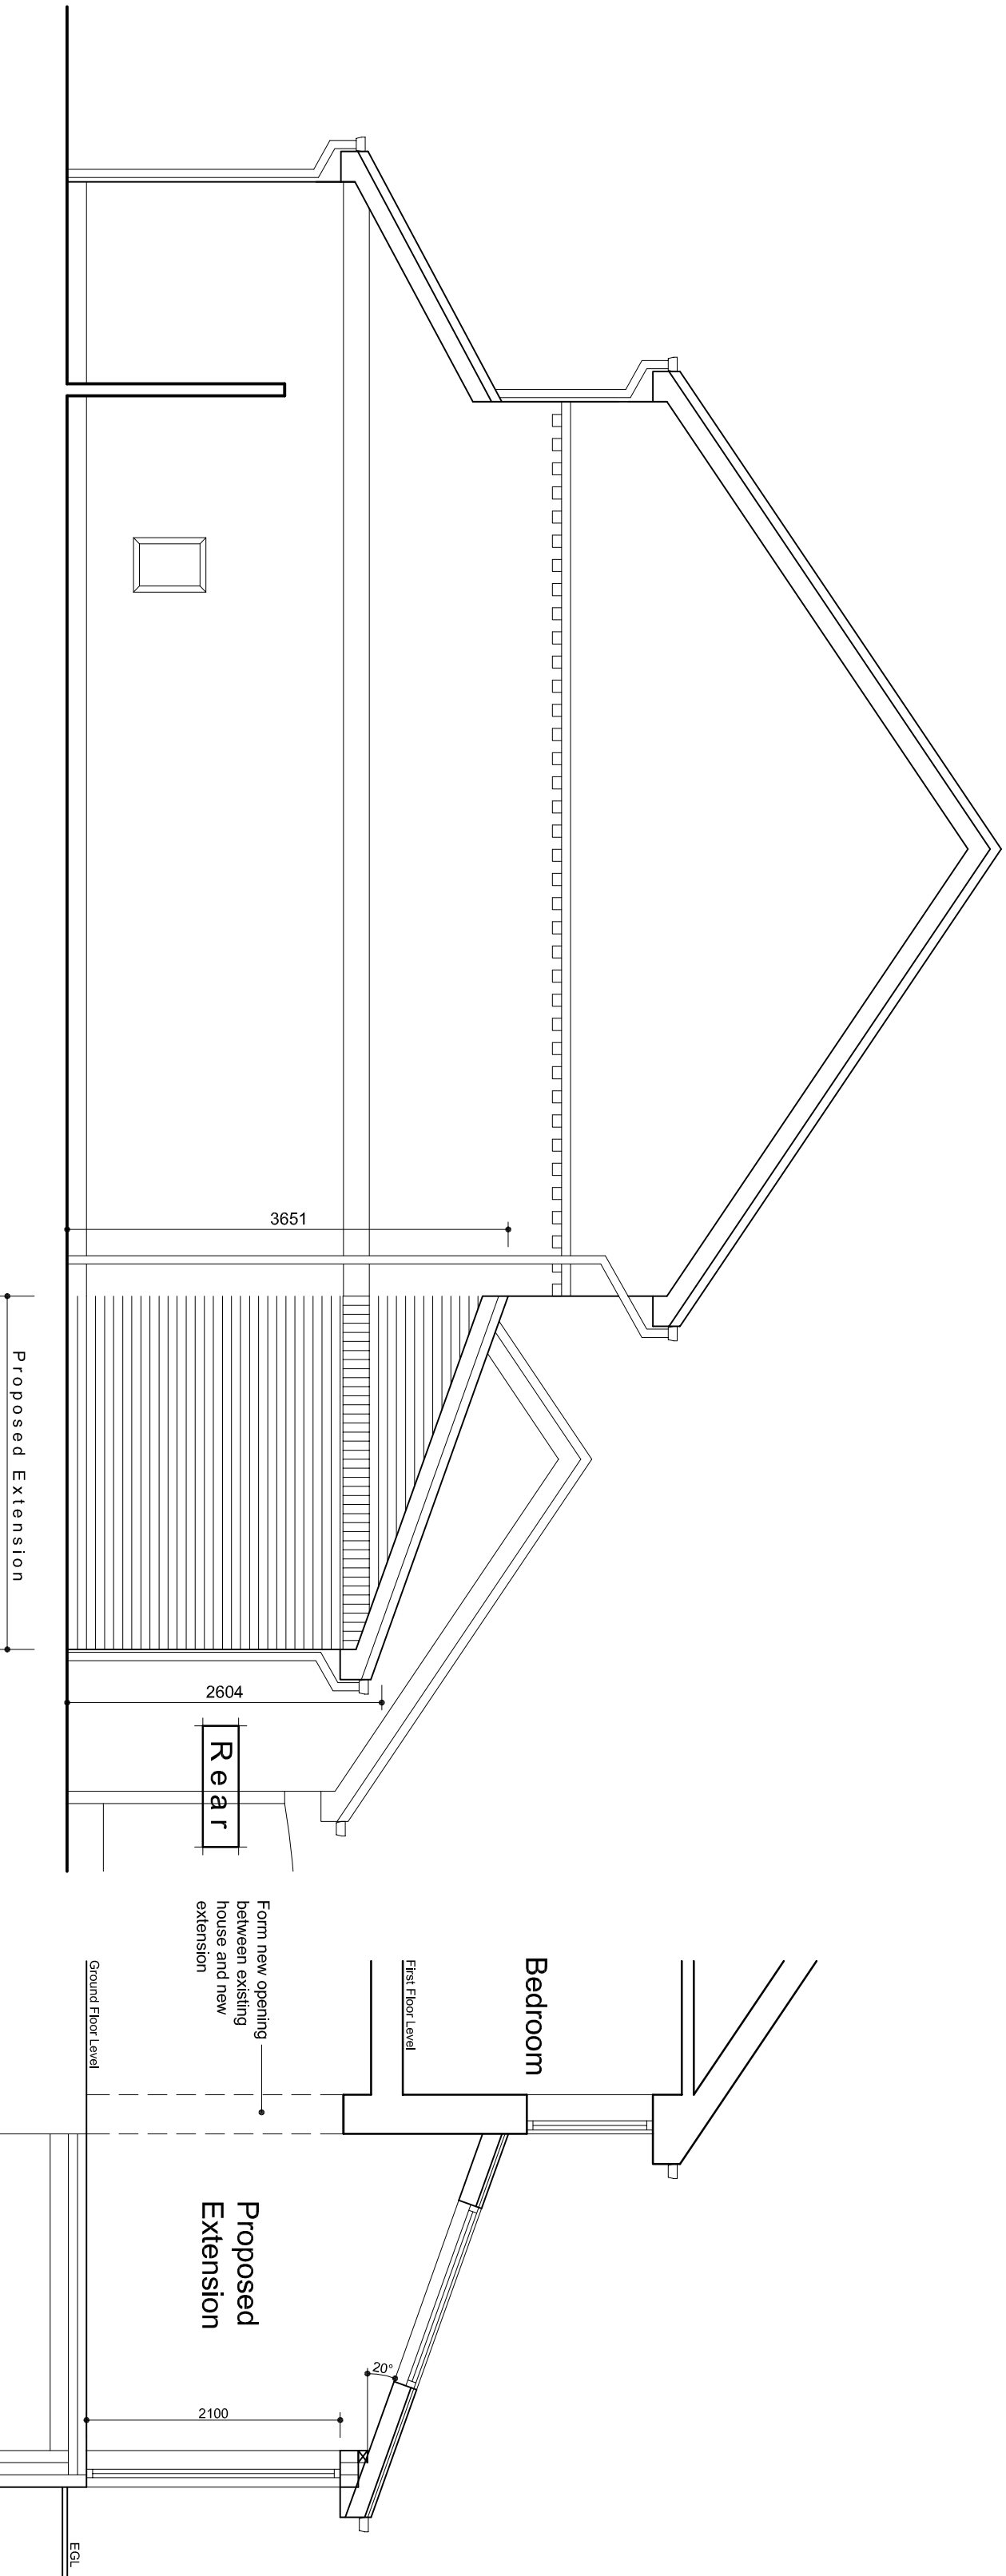

Proposed Rear Elevation

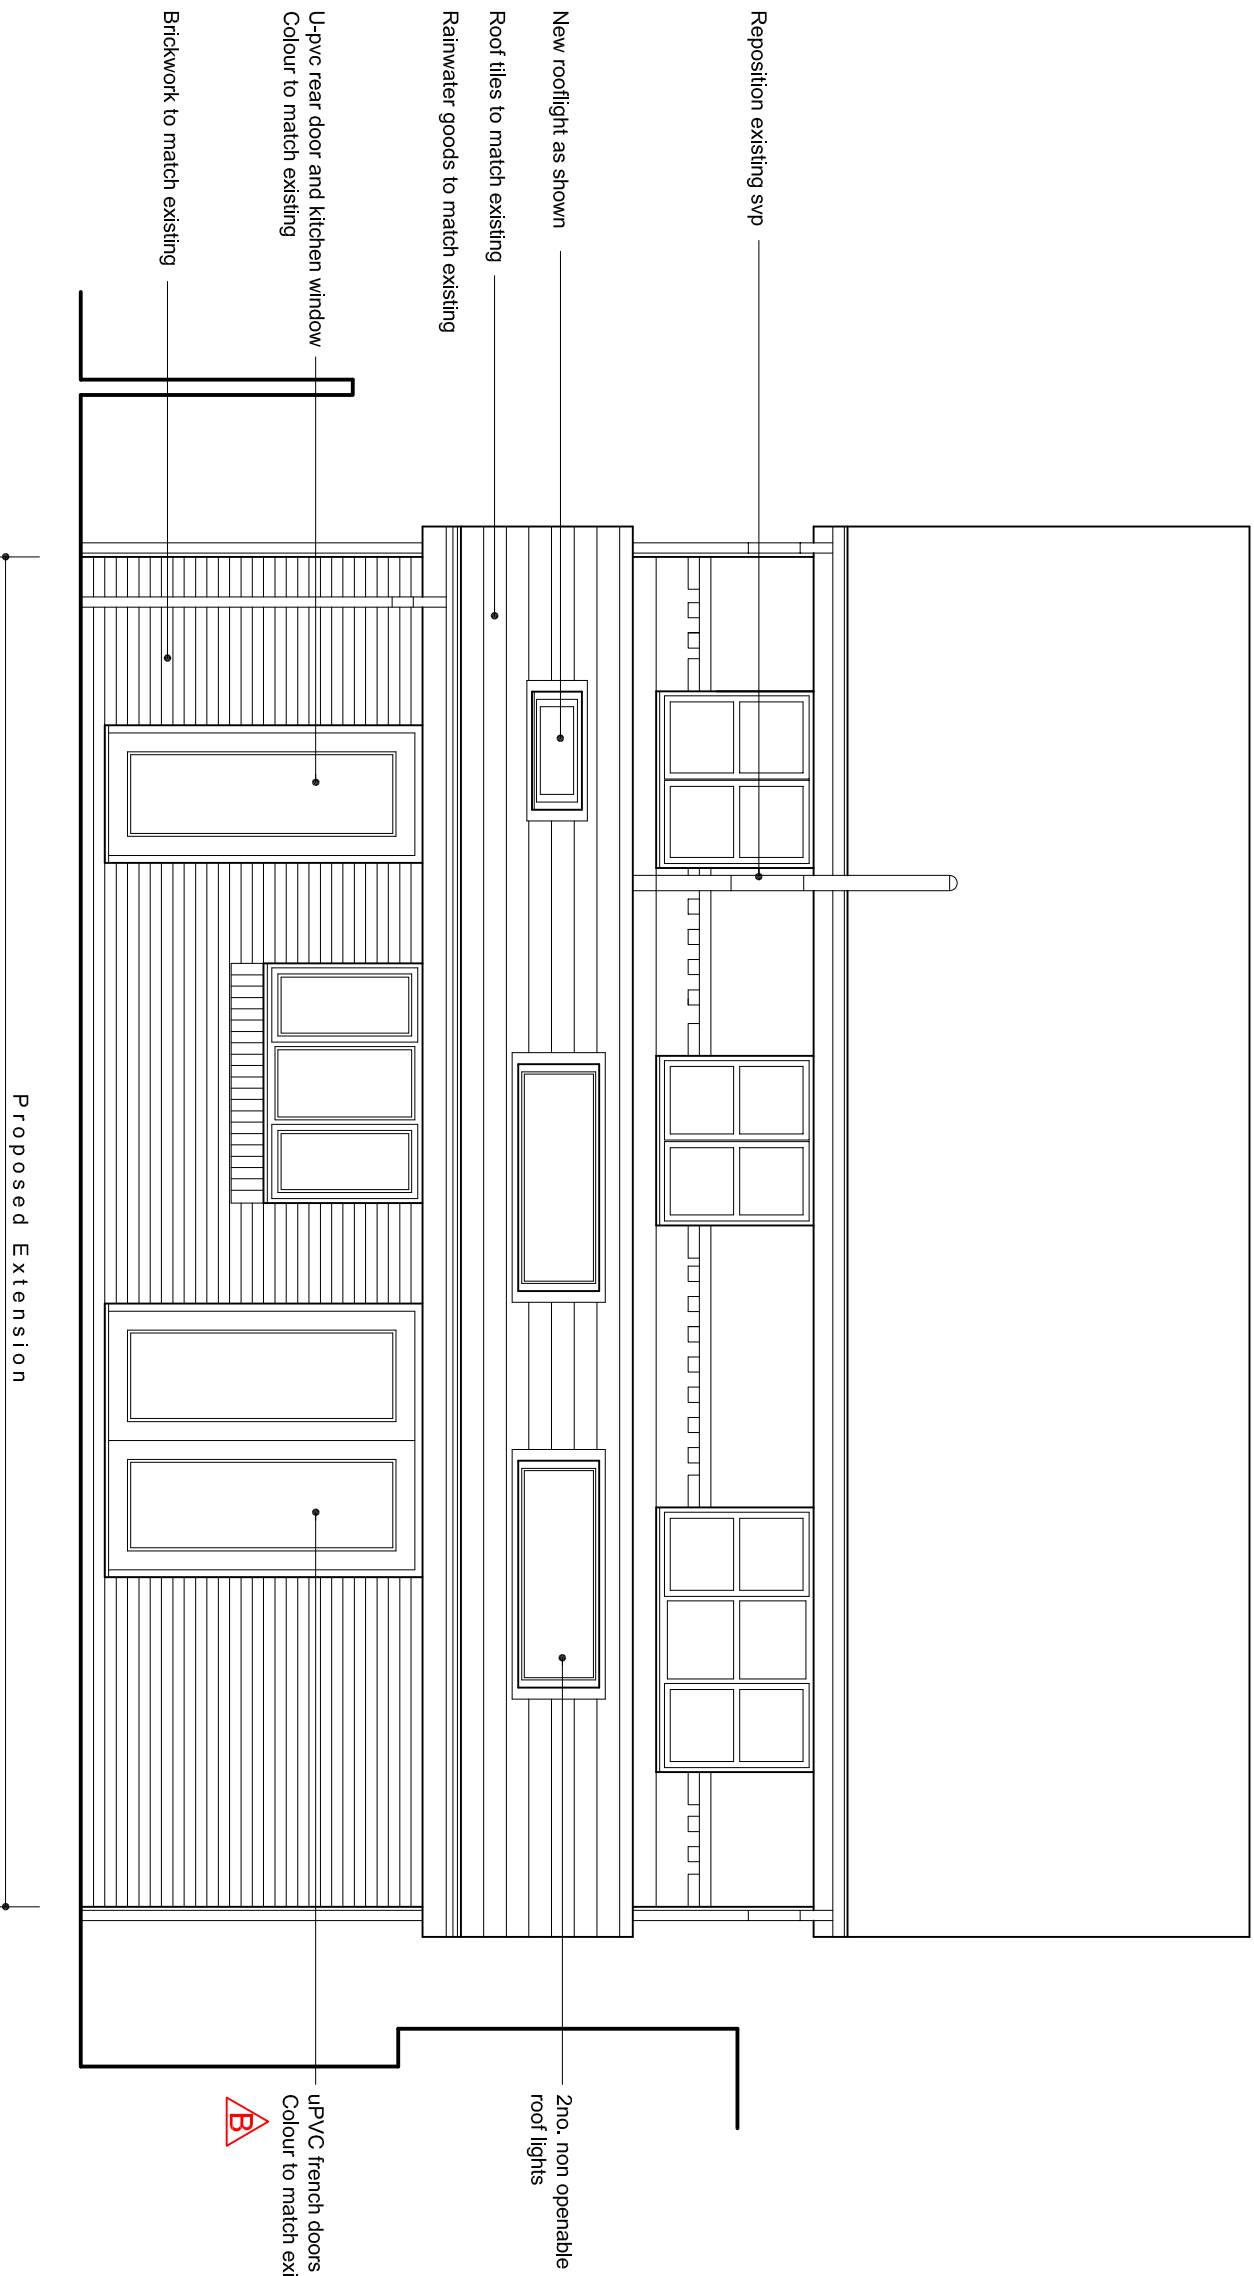

Preliminary Issue

B	Approved to be used for planning purposes only. This drawing is not to be used for construction purposes. It is a preliminary issue and is subject to change without notice. It is not to be used for any other purpose.	20/04/2022
A	Drawings updated to be in accordance with client comments. (See comments on drawings for details.)	21/04/2022
REV	DESCRIPTION	DATE

Mr & Mrs Dawson

PROJECT
Proposed Rear Extension at
9 Sutton Close, Bury

Proposed Floor Plan and Elevations

SCALE	DATE	DRAWN	CHECKED
1:50 A1	April 2022	MH	
DRAWING NO.	CAD REFERENCE NO.	REVISION	
R-0121-02		B	



Proposed Ground Floor Plan/Site Layout

