

NOTES

REVISIONS

PROJECT: 22 COCKEY MOOR ROAD, BURY.

CLIENT: SAEED POSTSHI


SCALE: 1:100 @ A1 SHEET

REFERENCE NO: 1423 - STREET SCENES

BARRY CULLEN
ARCHITECTURE LTD
email:barrycullenarchitecture@gmail.com
mob: 07851262695



STREET SCENE - AS BUILT

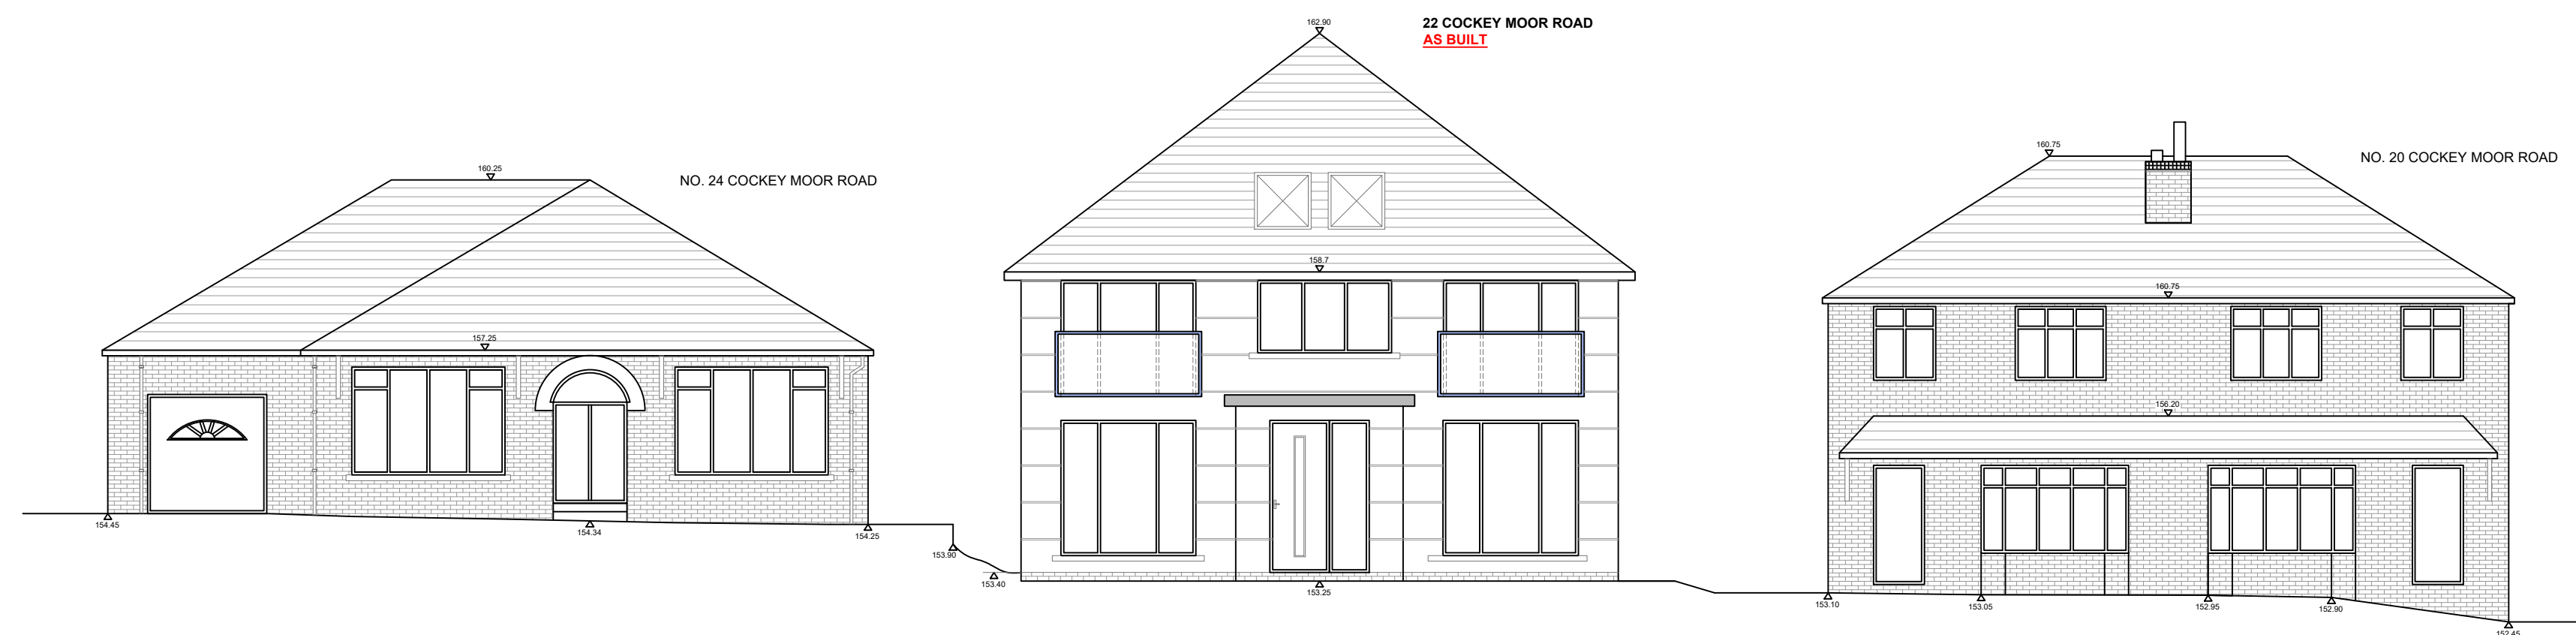

THIS LINE SHOWS THE ORDINANCE DATUM + 150M

STREET SCENE - AS PROPOSED



THIS LINE SHOWS THE ORDINANCE DATUM + 150M