




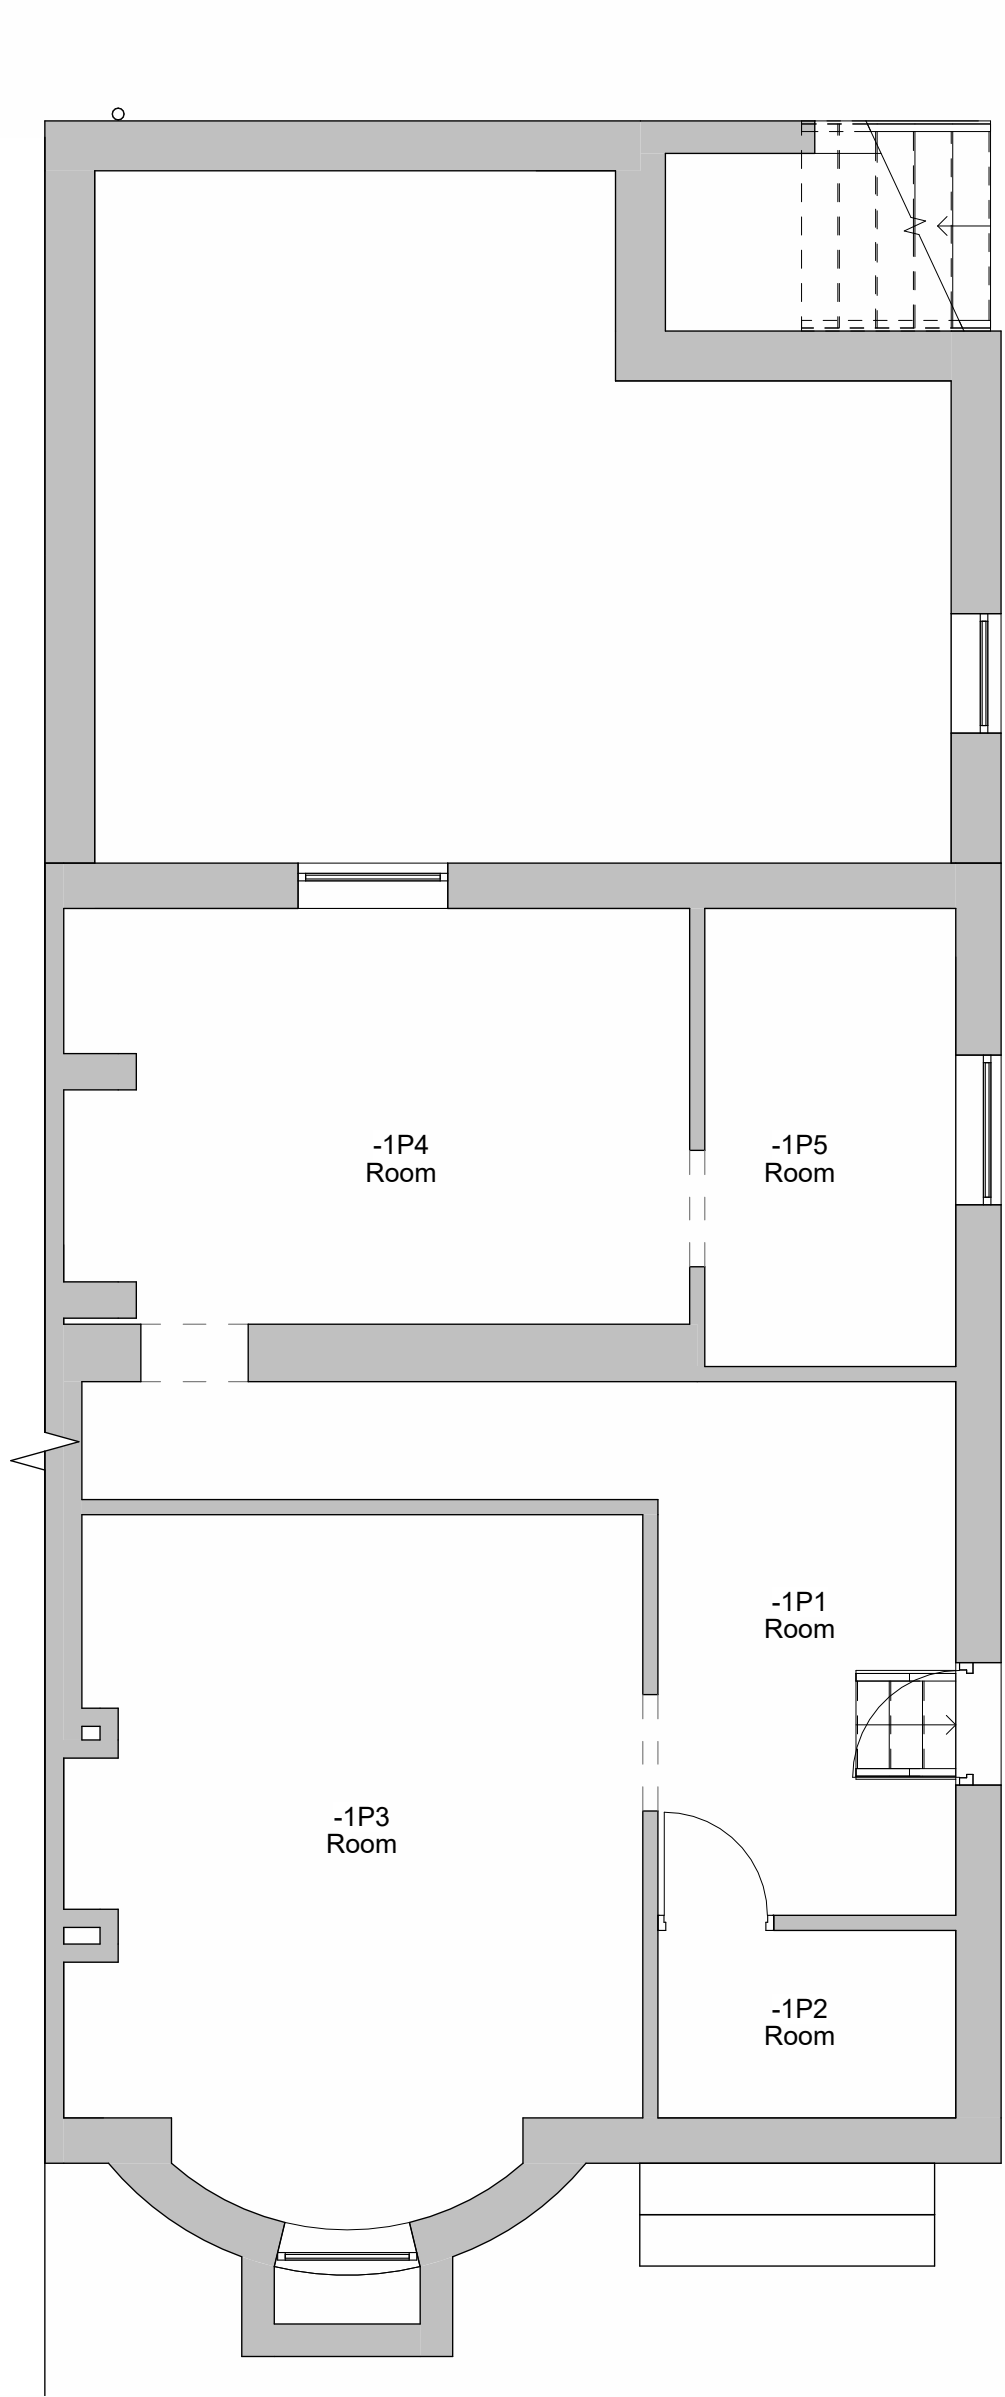


1 Level B1 - As Built
1 : 50

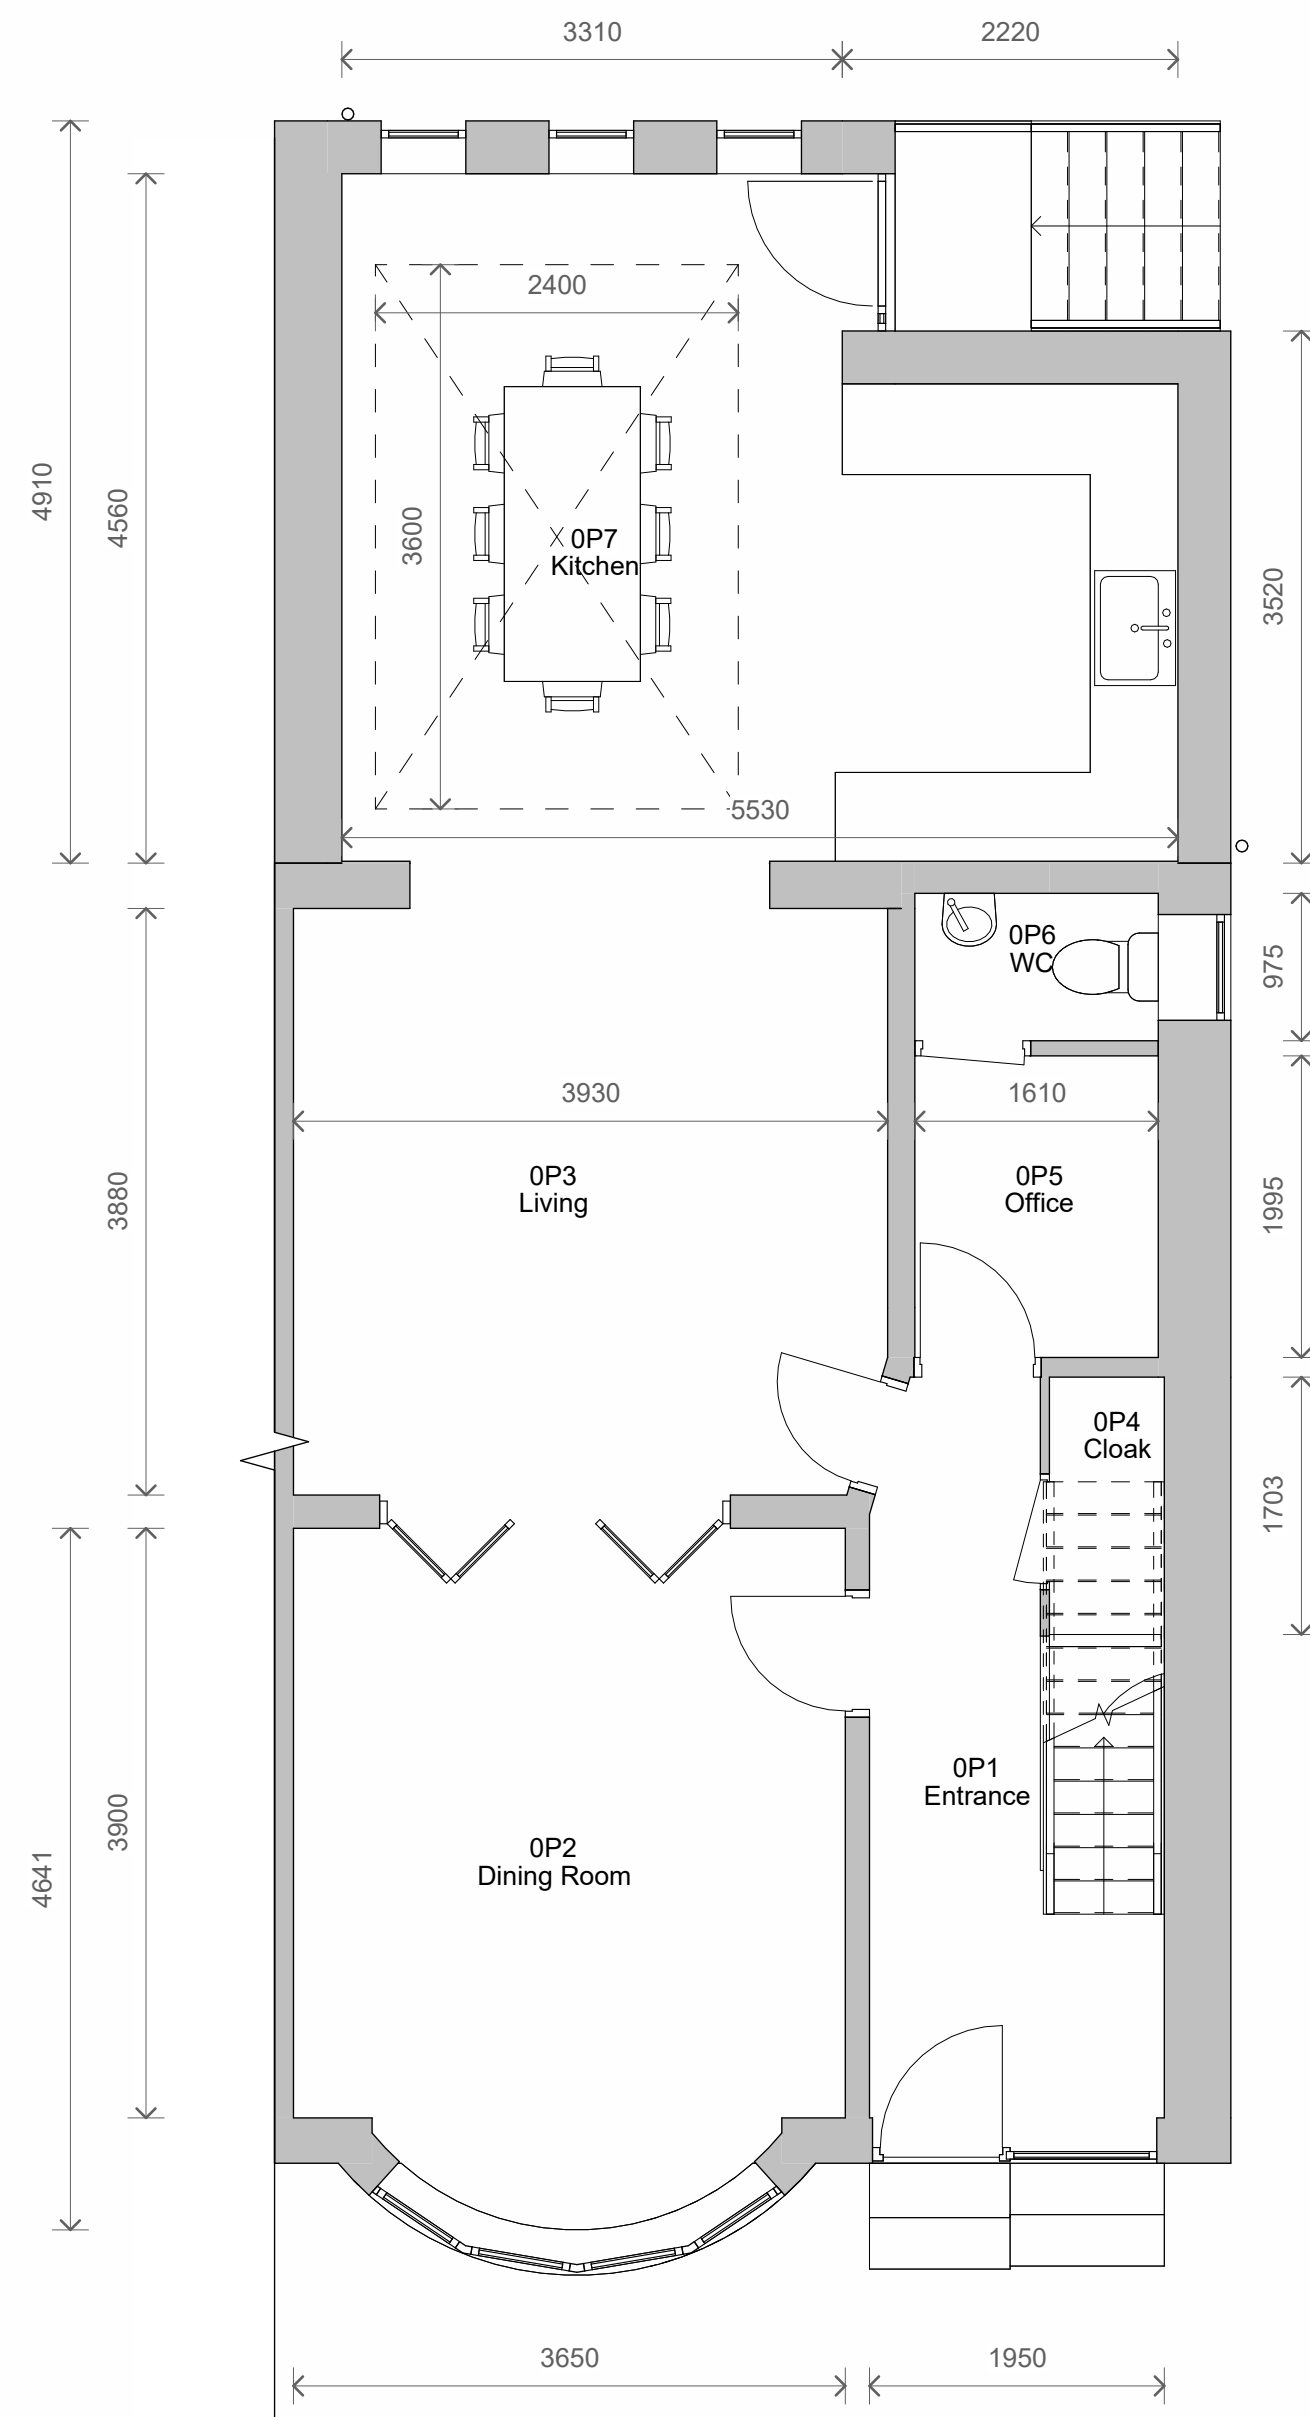

2 Level 0 - As Built
1 : 50

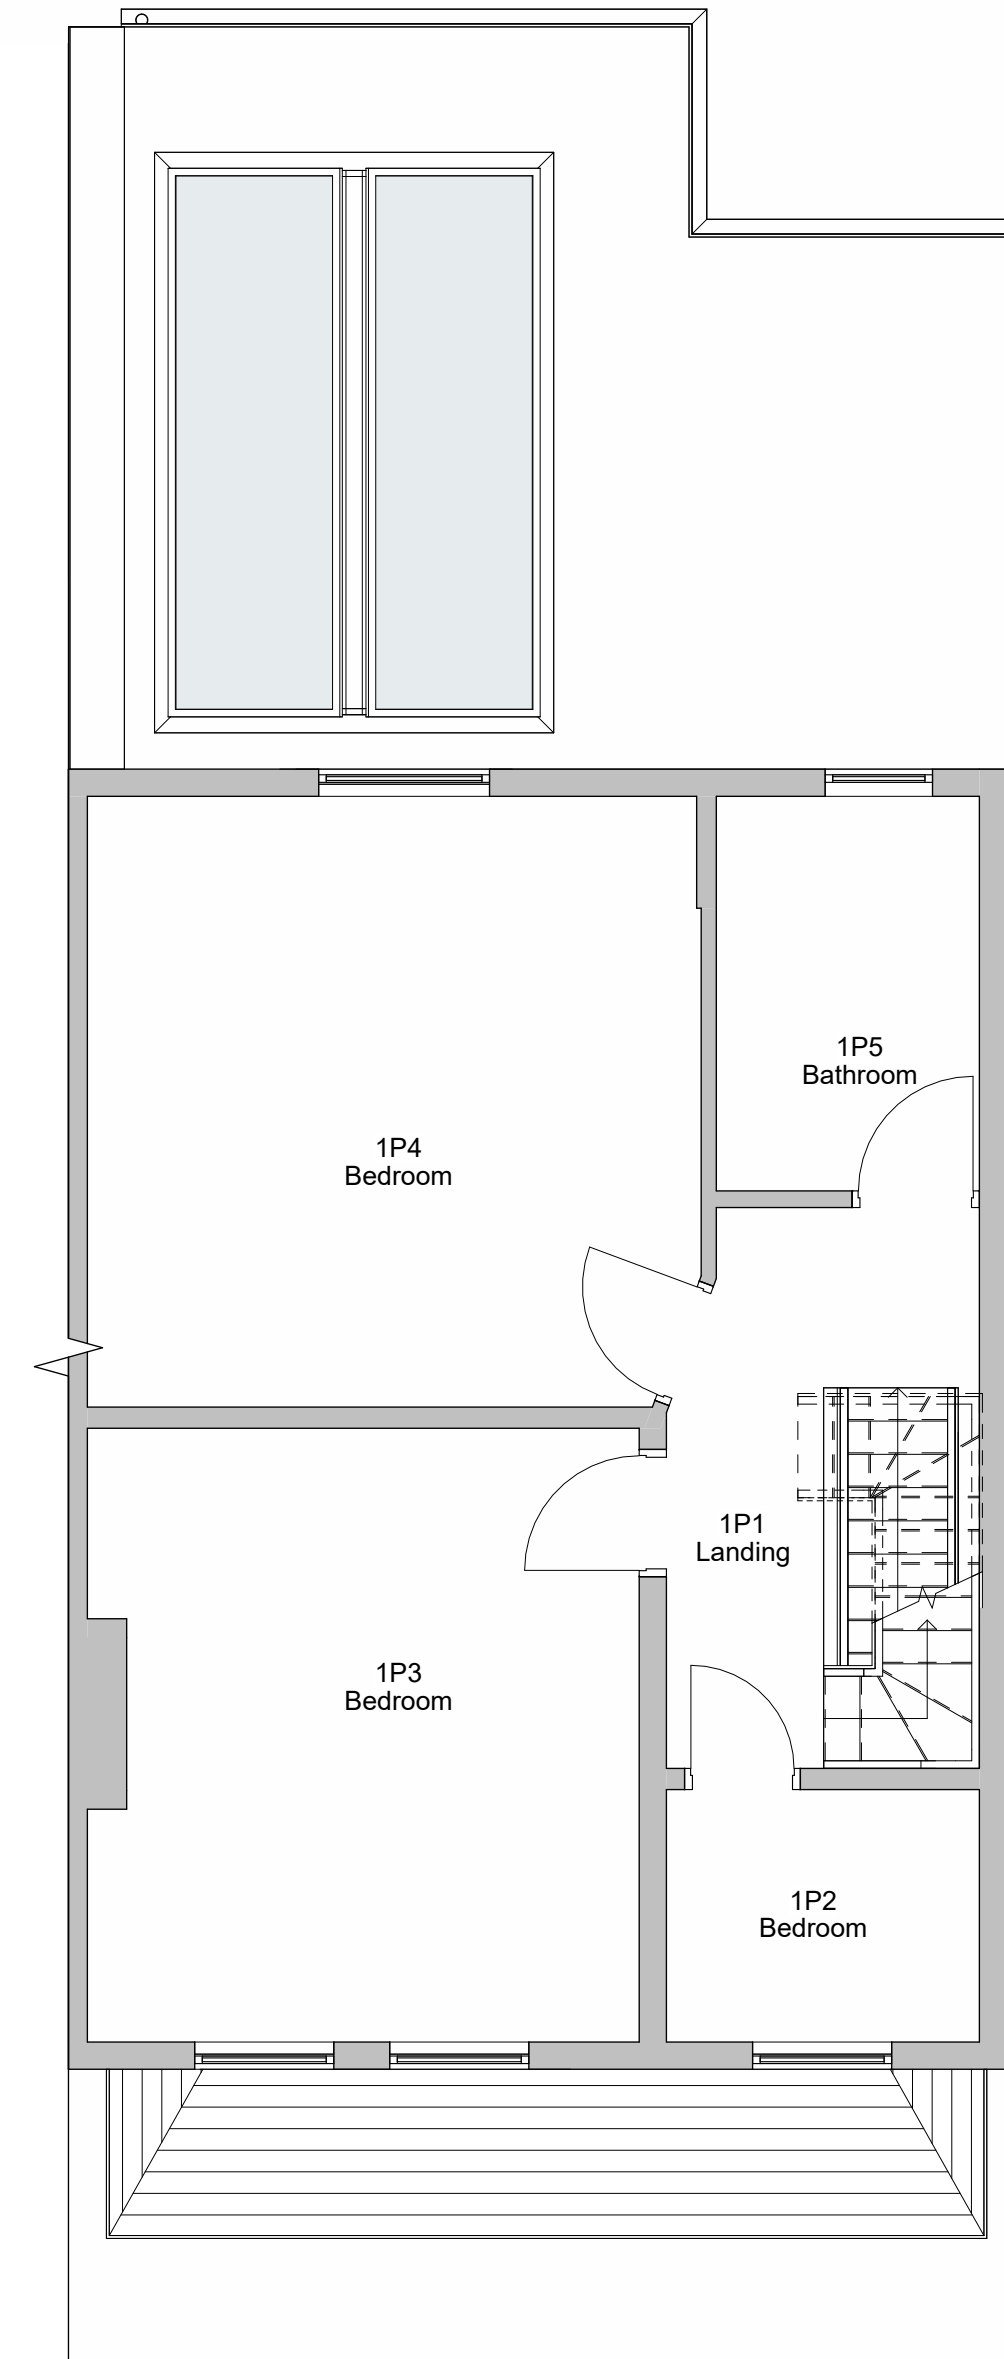


3 Level 1 - As Built
1 : 50

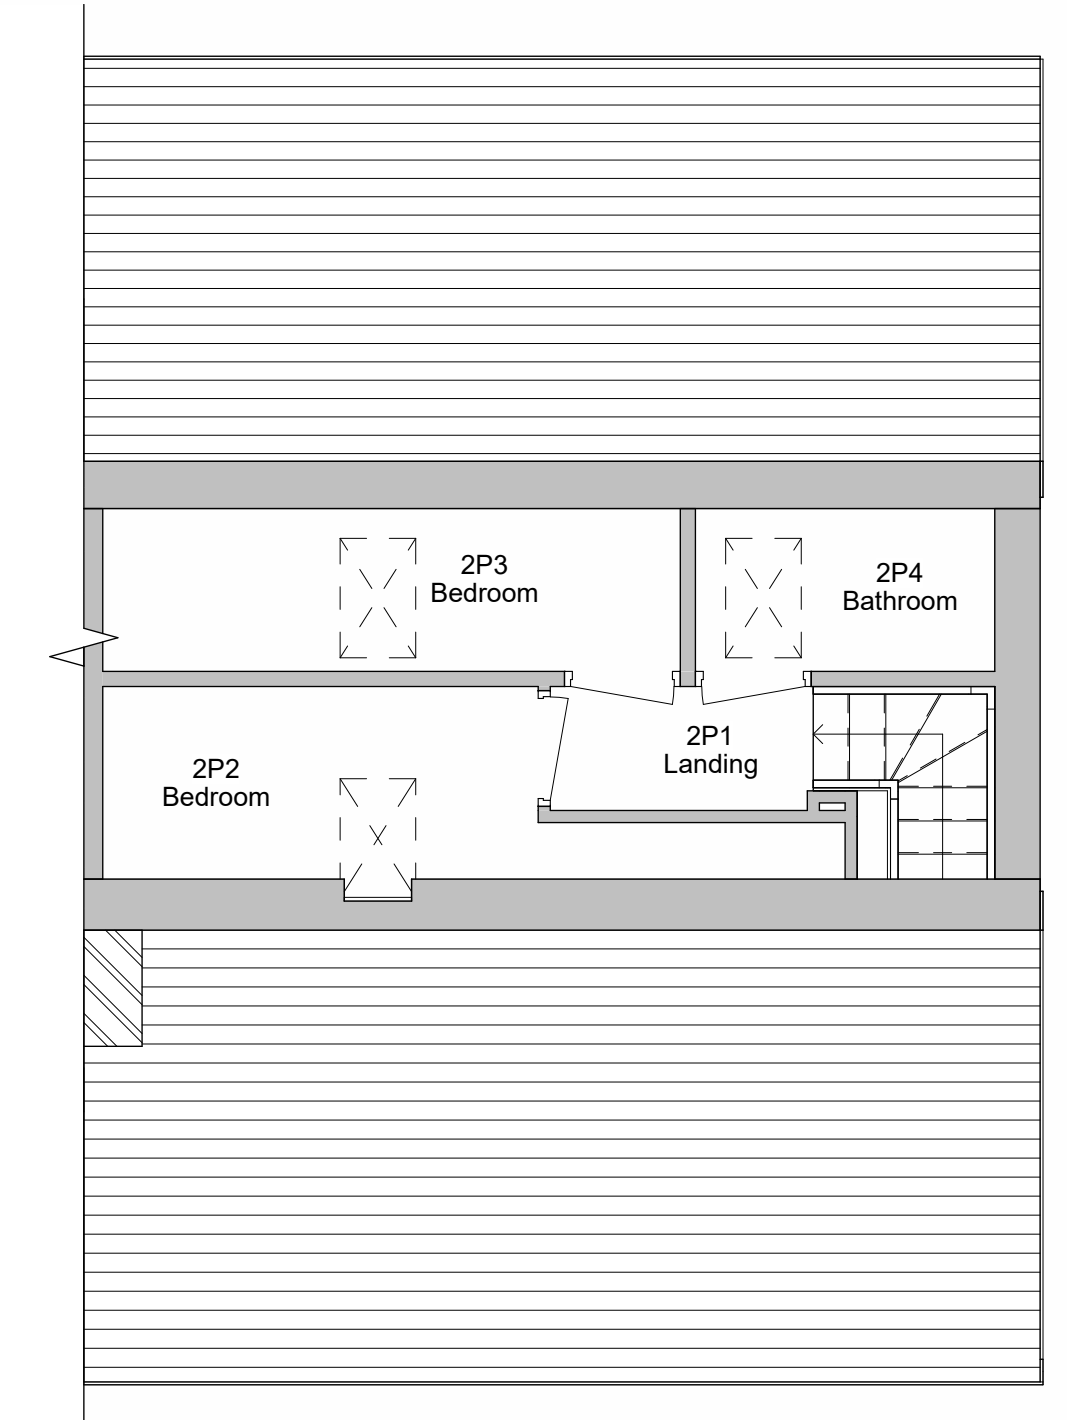

4 Level 2 - As Built
1 : 50




5 Front - As Built
1 : 100

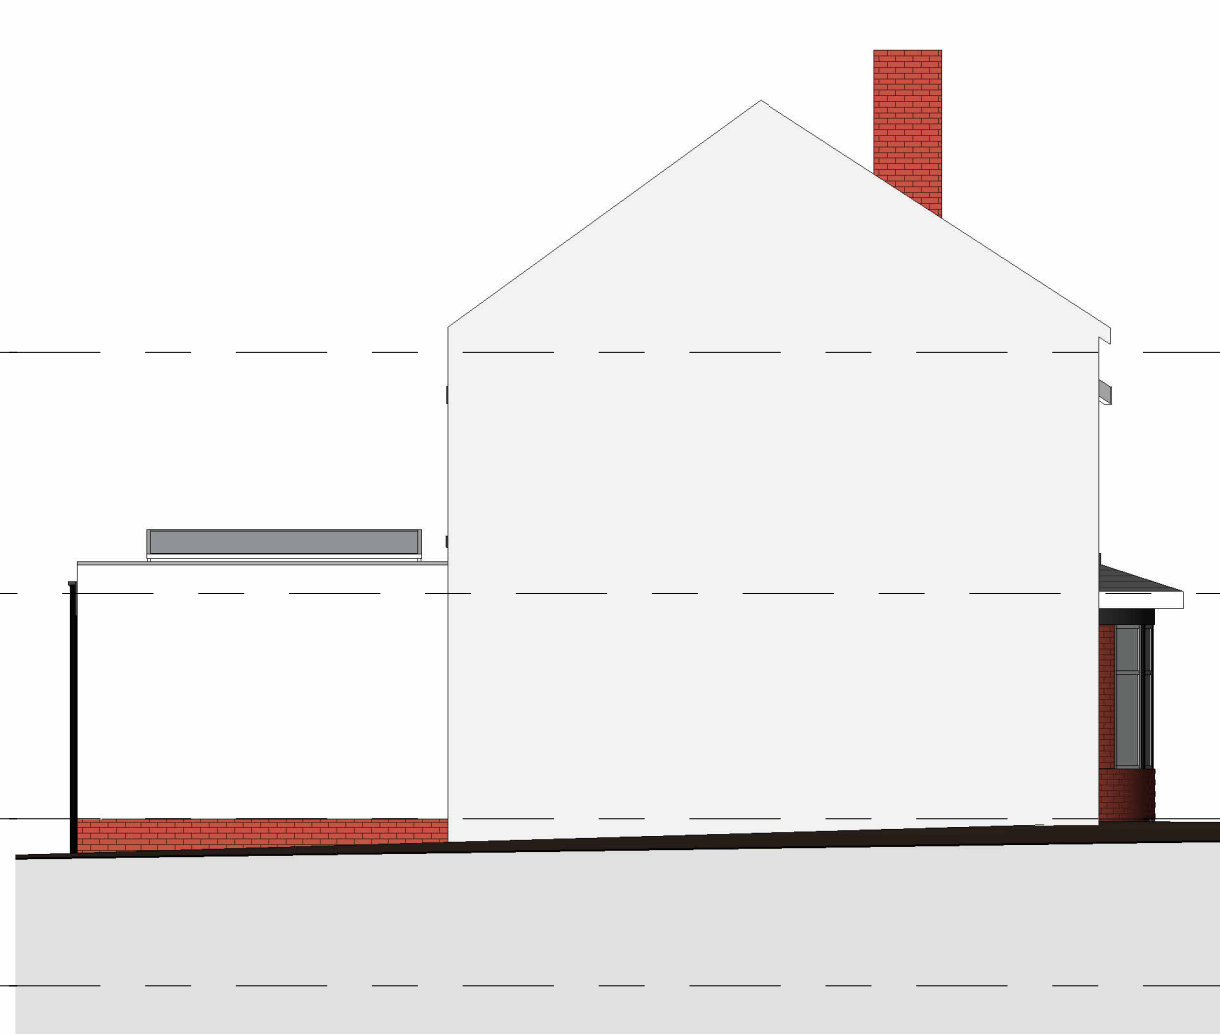


6 Left Side - As Built
1 : 100



7 Rear - As Built
1 : 100

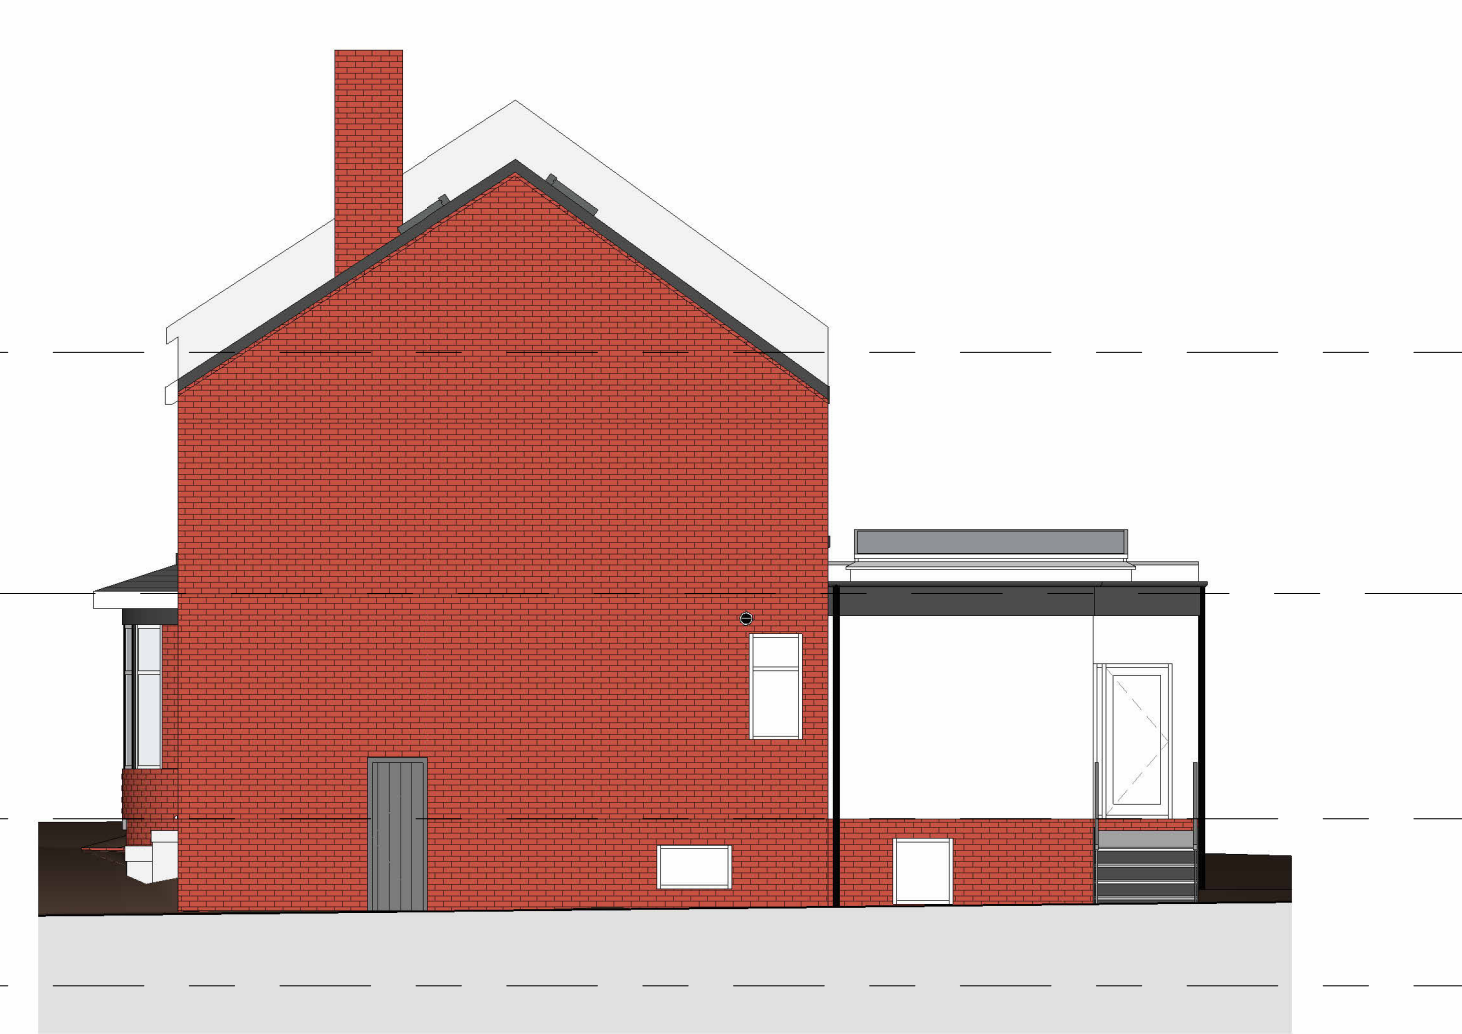

8 Right Side - As Built
1 : 100

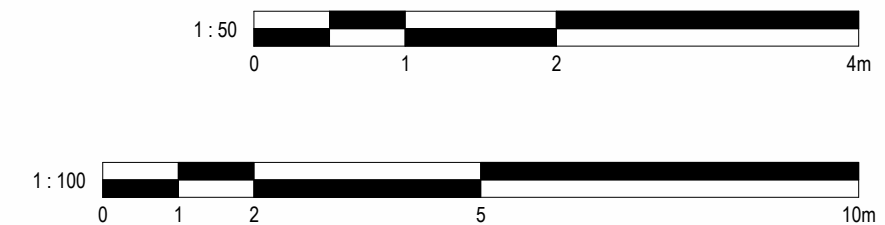

No.	Description	Date
PROJECT		
5 Jesmond Avenue		
TITLE		
As Built Plans and Elevations		
CLIENT		
Bamberger		
STATUS		
AS BUILT		
DRAWN BY	DATE	SCALE (@ A1)
JB	29/05/2025	As indicated
PROJECT NUMBER	DRAWING NUMBER	REV
GSS22004.2	004	
GOLD SKETCH		
S T U D I O S		
www.goldsketch.co.uk info@goldsketch.co.uk 0161 792 9595		
NOTES		
© COPYRIGHT - ALL RIGHTS RESERVED. THIS DRAWING IS NOT TO BE REPRODUCED WITHOUT PRIOR WRITTEN CONSENT. DRAWING TO BE USED FOR THE STATUS INDICATED ONLY. ALL DIMENSIONS AND SETTING OF WALLS, FLOORS AND ROOFS TO BE IN ACCORDANCE WITH CURRENT BUILDING REGULATIONS AND RELEVANT CODES OF PRACTICE AND BRITISH STANDARDS. ALL DIMENSIONS ON THIS DRAWING ARE IN MILLIMETRES UNLESS OTHERWISE STATED.		