


CDM 2015

Client notified of duties: At Design Workshop


Principal Designer: Client

Unless noted below, all known hazards have been highlighted on this drawing

Demolition lines	
New construction	
Possible steel (specialist to advise)	

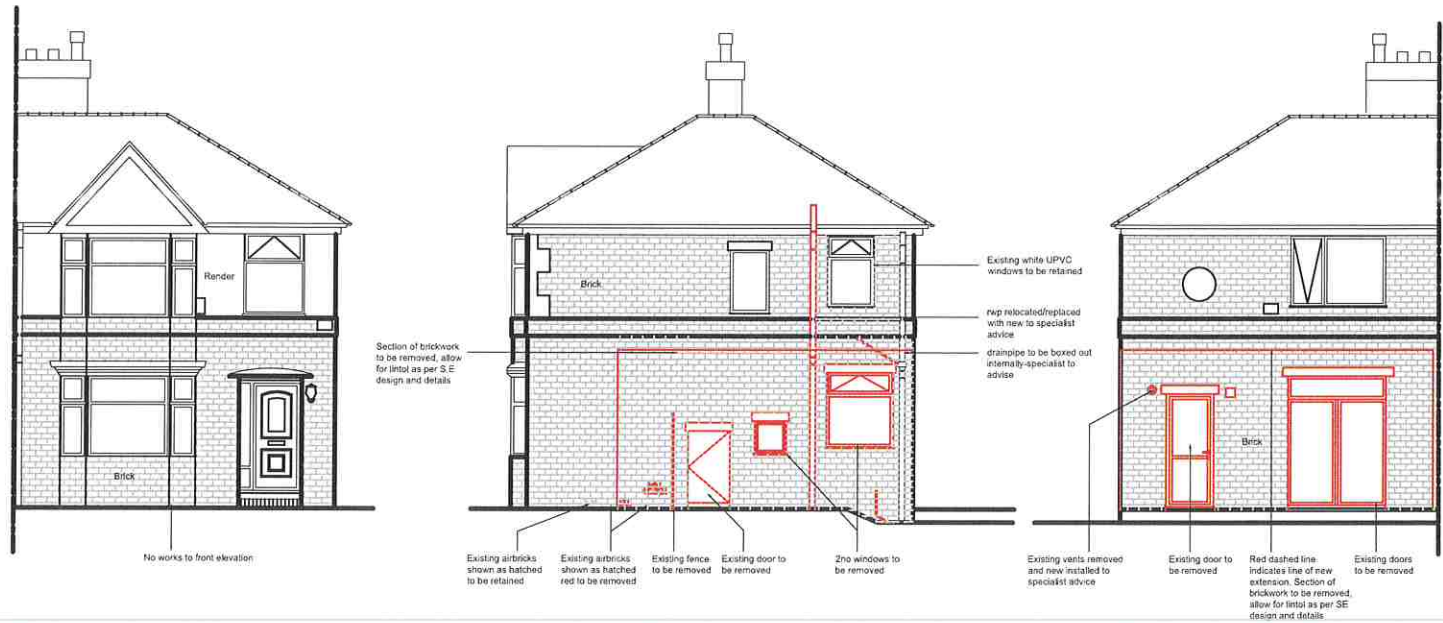

EXISTING EXTERNAL ELEVATIONS
Scale 1:100

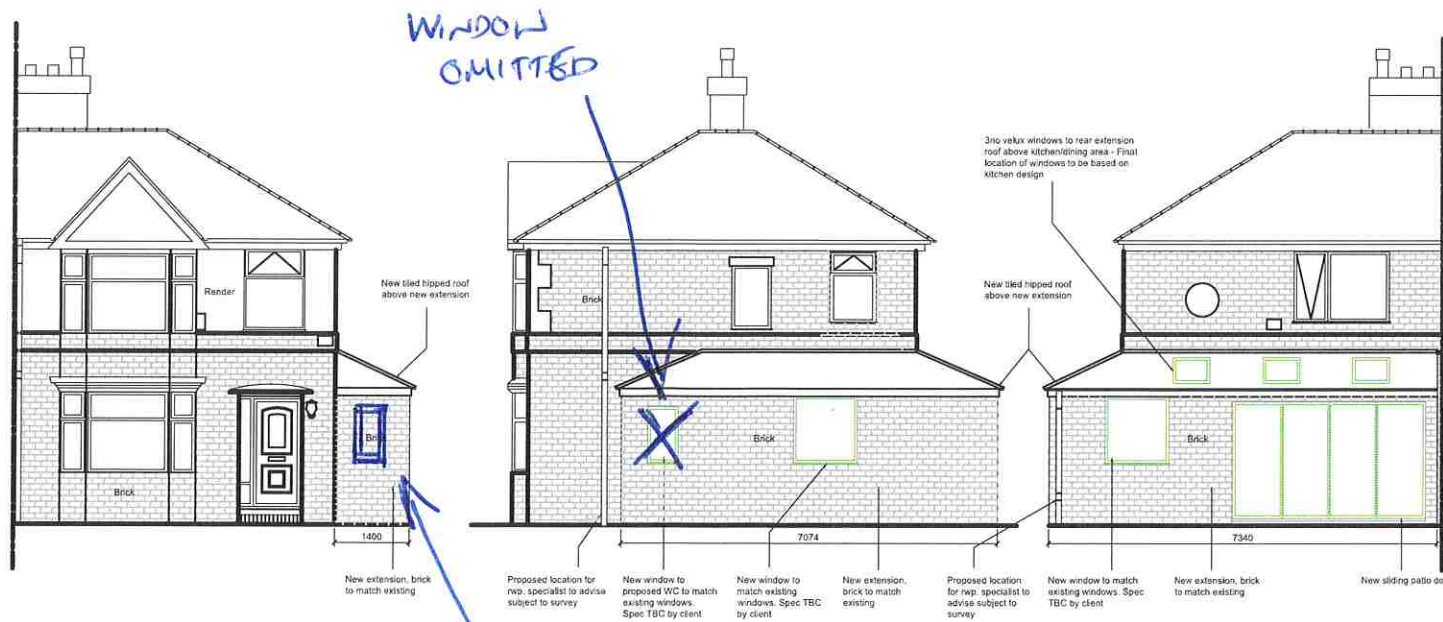

PROPOSED EXTERNAL ELEVATIONS
Scale 1:100

WINDOW OMITTED

WINDOW RELOCATED TO FRONT ELEVATION

0 1000 2000 3000 4000 5000mm
SCALE 1:100

Rev: P3	Date: 18.01.23	Drawn: MT	Checked: ST
PLANNING UPDATES			
• Scale changed to 1:100 @A2			
Rev: P2	Date: 16.07.21	Drawn: HE	Checked: LG
STAGE 2 UPDATES			
• Based on client mark up sent 05.07.21			
• Additional window shown			
• Indicative locations for velux windows shown			
Issue:	For Planning	Stage:	S2
Client:	P. Shyvers		
Project:	3 Freshfield Avenue, Prestwich Manchester, M25 2GU		
Title:	Existing and Proposed External Elevations		
Date:	24.06.2021	Drawn:	HE
Scale:	1:100 @ A2	Checked:	LG
Dwg N°:	202018_M1NT_XX_ZZ_A_DR_0005		
M1NT STUDIO	www.m1ntstudio.com hello@m1ntstudio.com		
Rev P4			Rev