


As Built Elevation

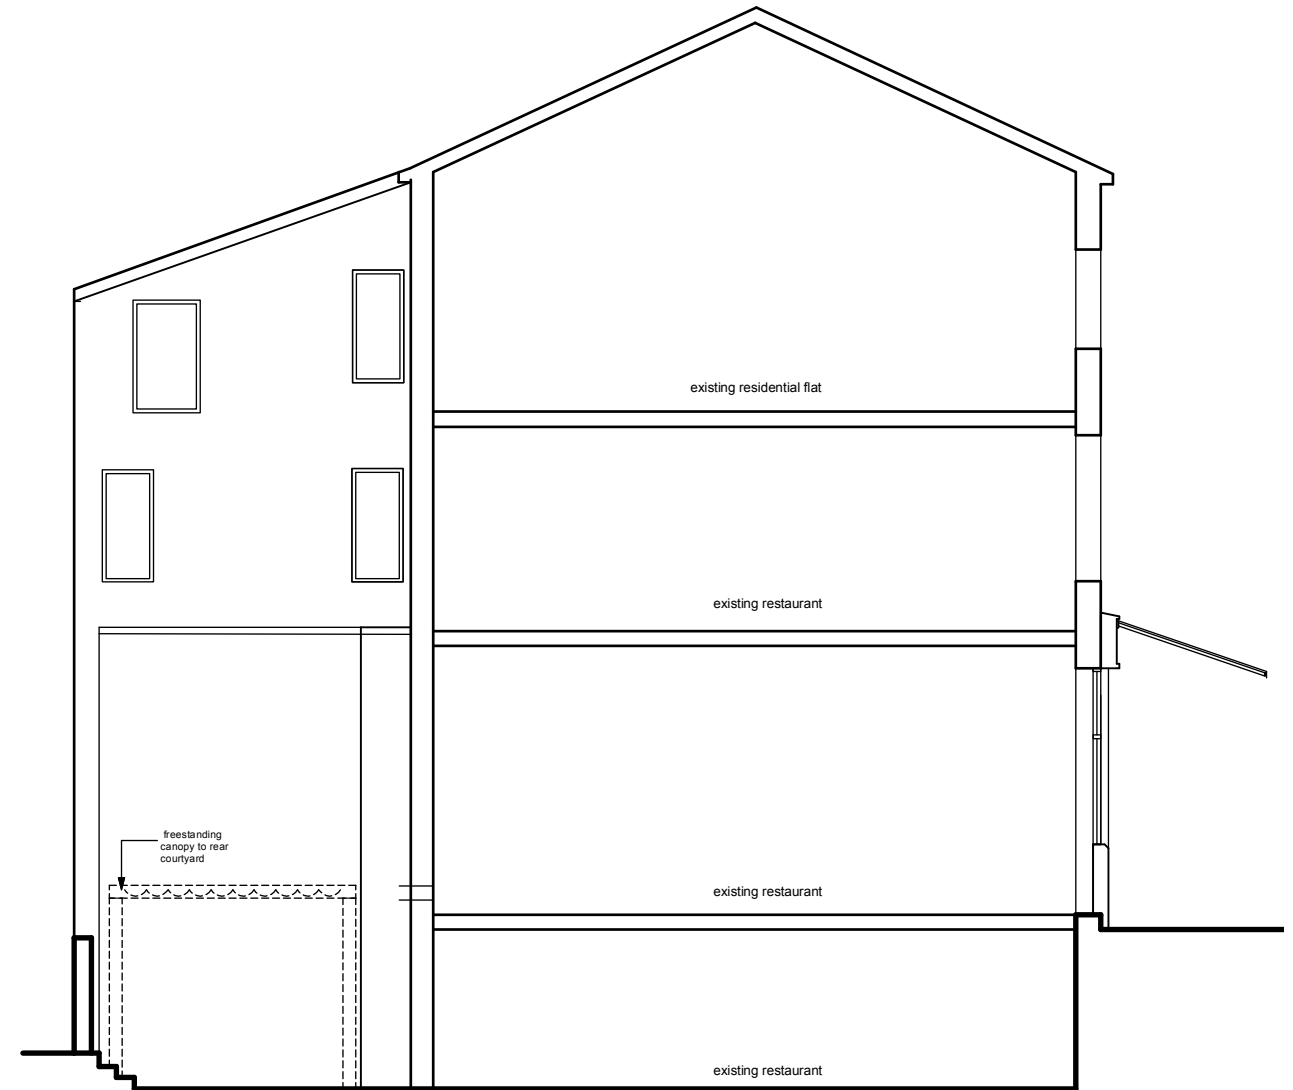

As Built Section / Side Elevation

Rev	Description	Date	By
A	Notes added to clarify existing use to first floor	07/10/24	SPL

Date:
October 2020

Drawing No:
24160/P/03-A

Project:
Cuckoo Bar
395-397 Bury New Road
Manchester M25 1AW

Drawing:
As Built Front & Rear
Elevations

SCALE 1:100

leighton
architects
21 chandos Road
Manchester M21 0ss
Tel/ 07747111159
www.leightonarchitects.com