


Proposed Rear Elevation

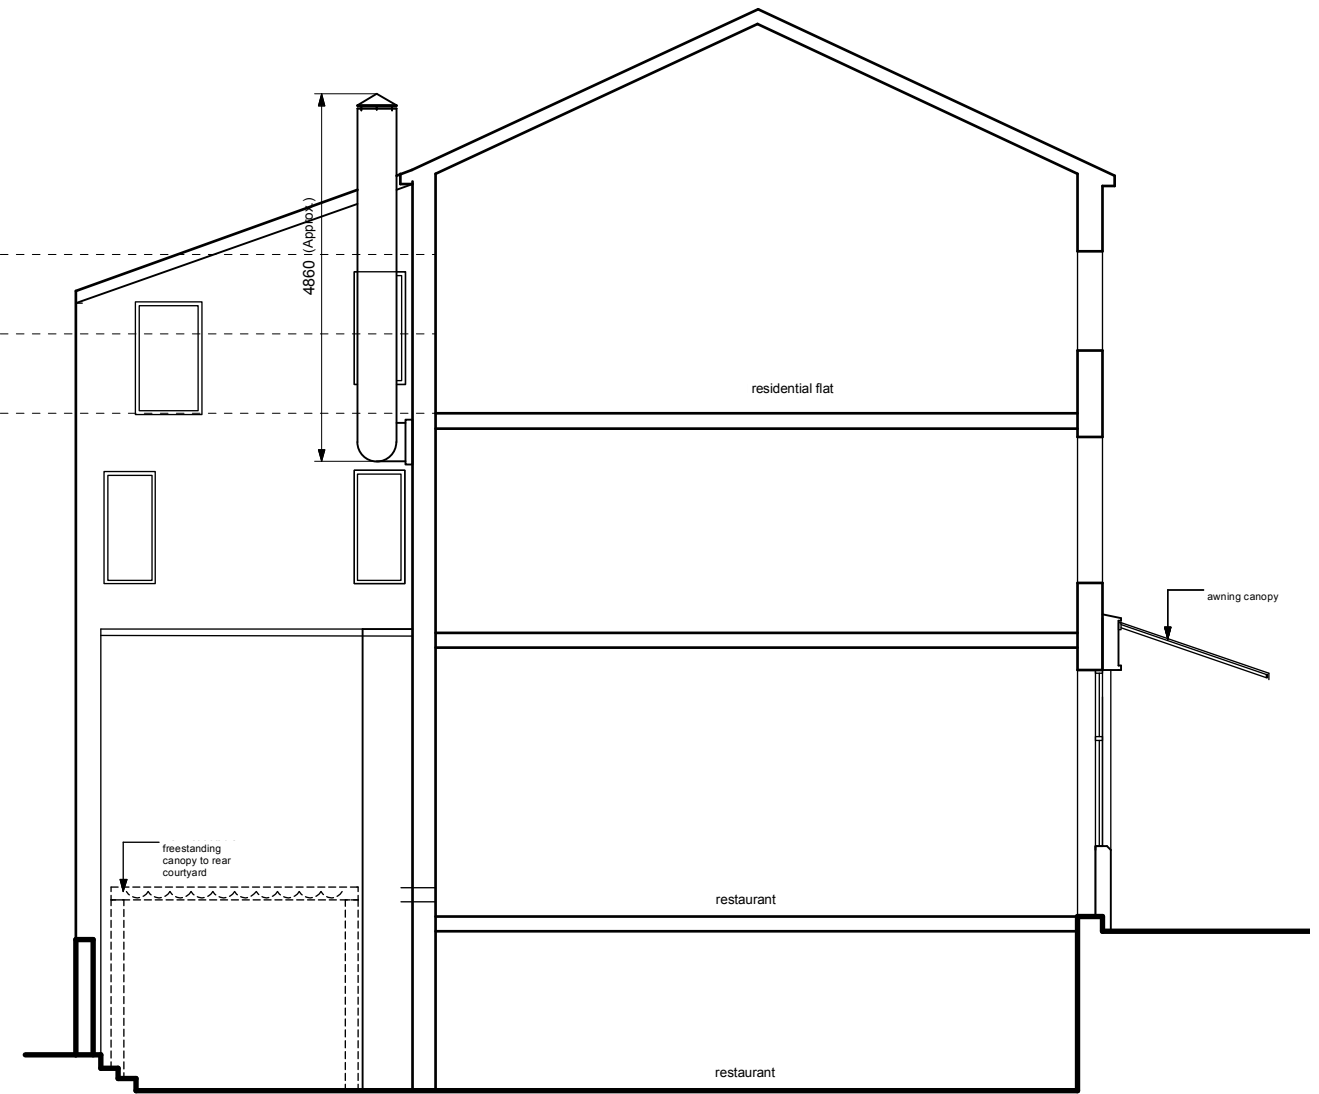

Proposed Section / Side Elevation

Rev	Description	Date	By
-----	-------------	------	----

Date:
August 2024

Drawing No:
24160/P/04

Project:
Cuckoo Bar
395-397 Bury New Road
Manchester M25 1AW

Drawing:
As Built Front & Rear
Elevations

SCALE 1:100

**leighton
architects**
21 chandos Road
Manchester M21 0ss
Tel/ 07747111159
www.leightonarchitects.com