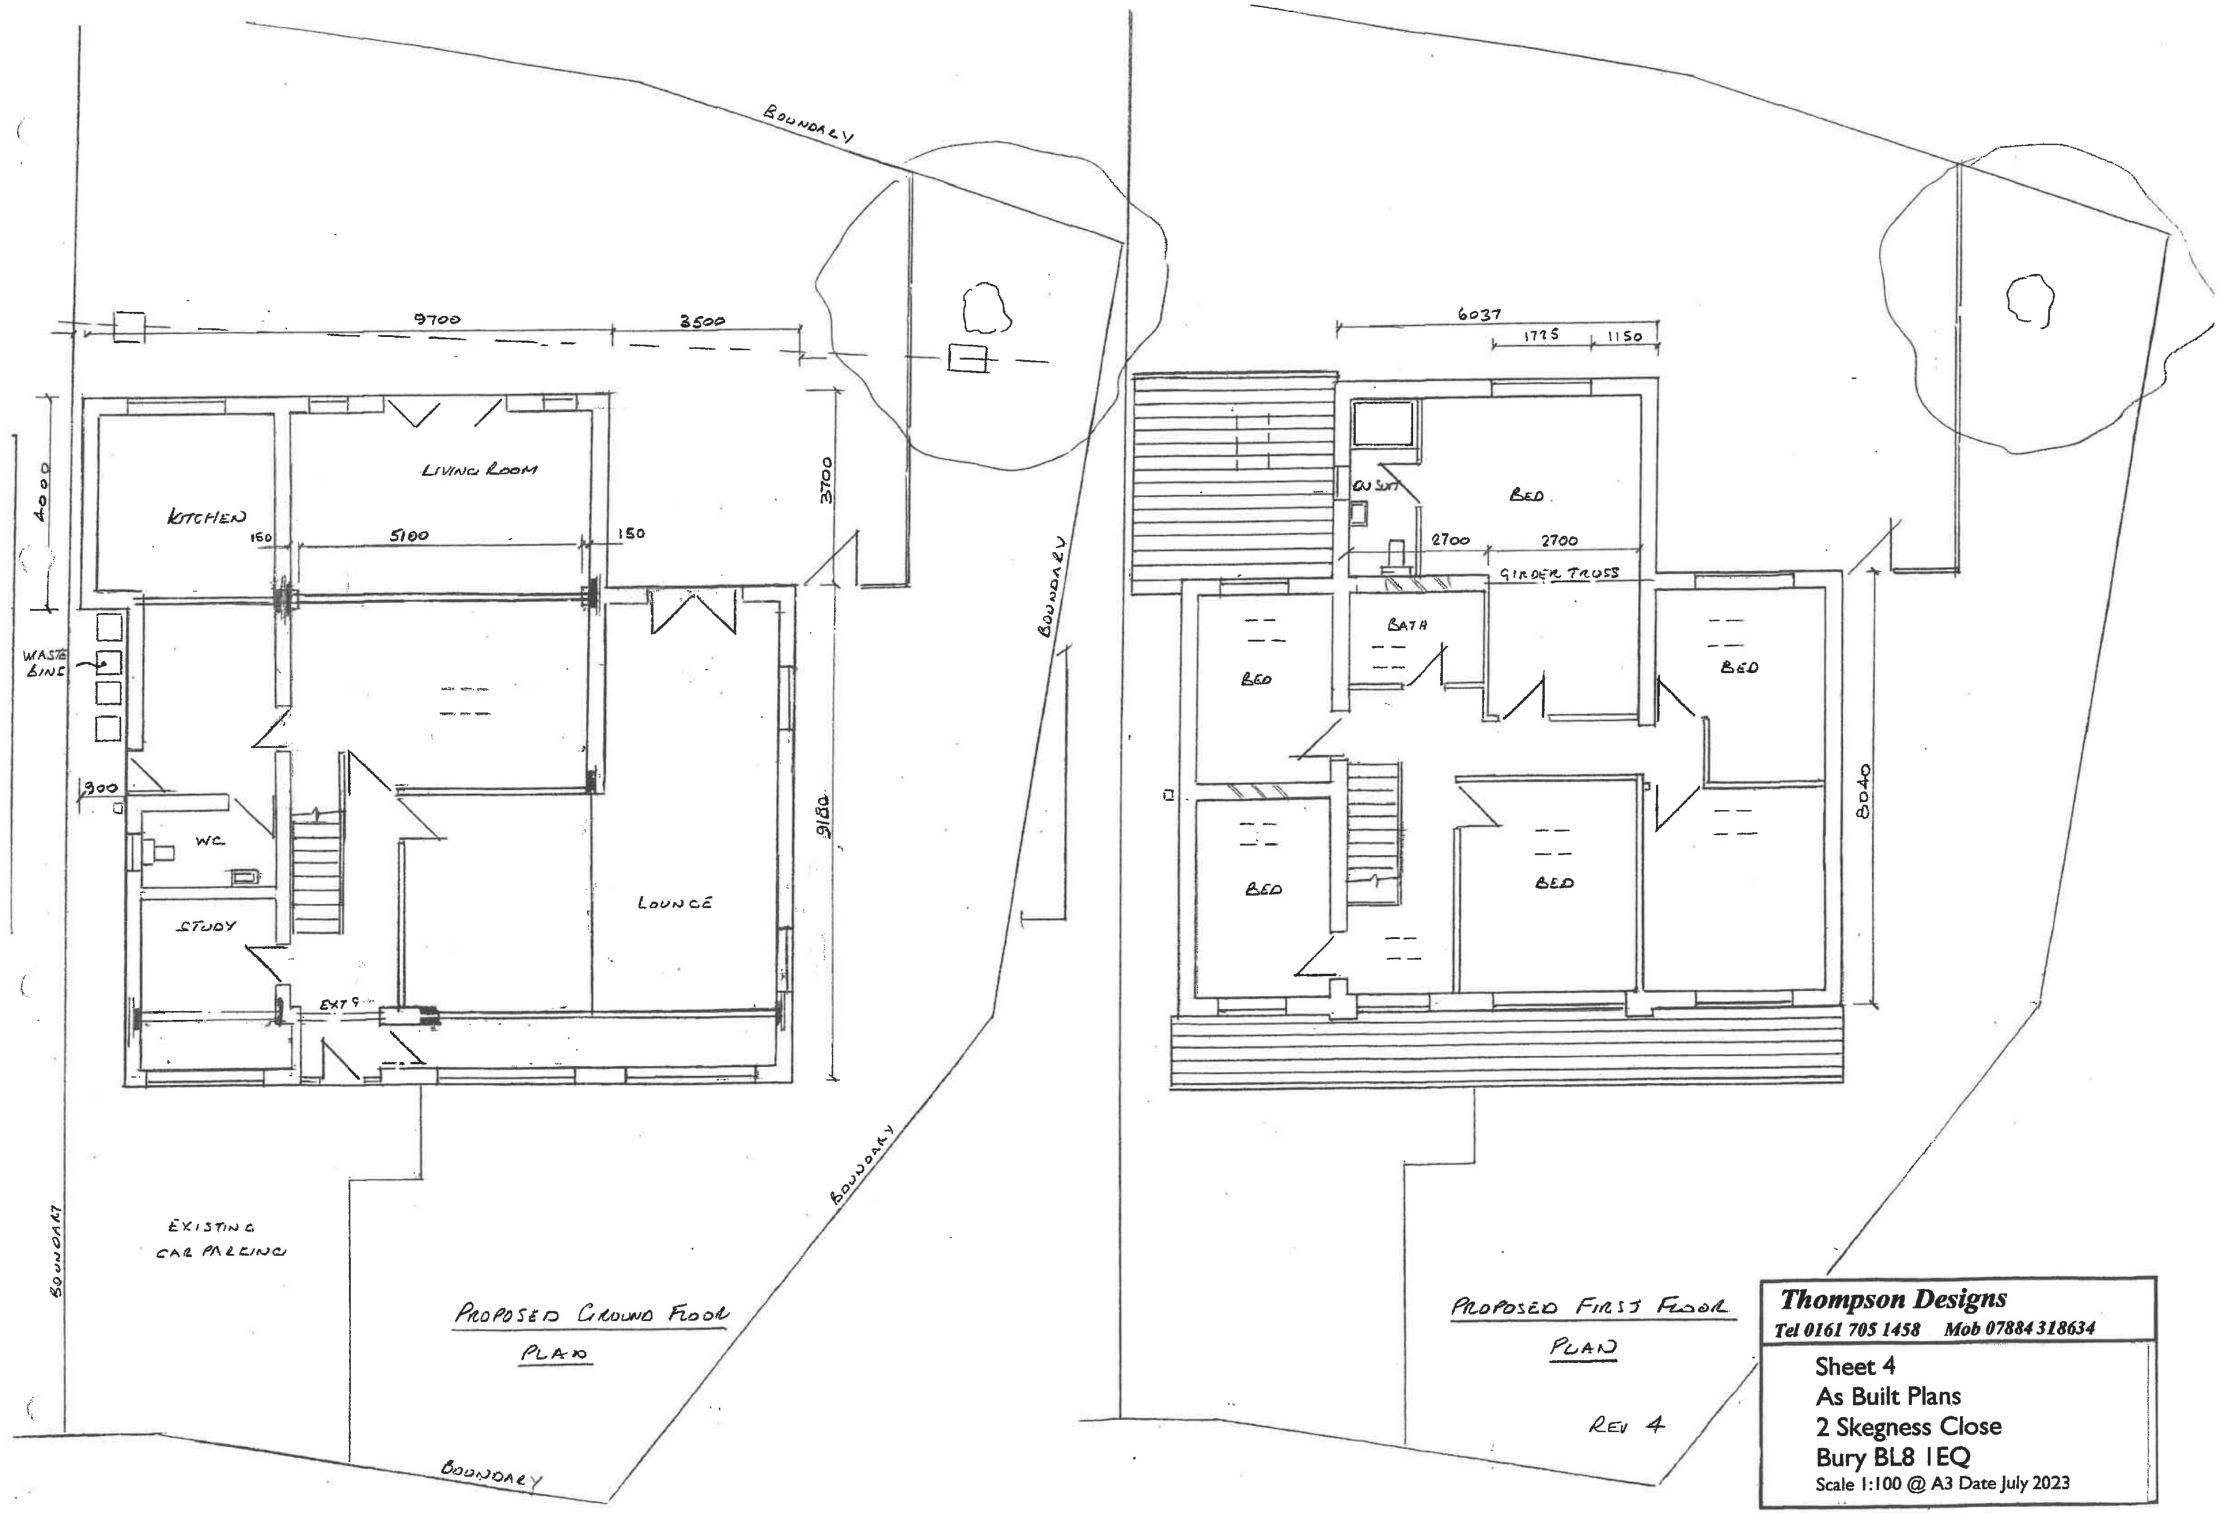


**Thompson Designs**
Tel 0161 705 1458 Mob 07884 318634

Sheet 4
As Built Plans
2 Skegness Close
Bury BL8 1EQ
Scale 1:100 @ A3 Date July 2023