

This drawing is the property of IPS Architects and copyright is reserved by them.
This drawing is not to be copied or disclosed by or to any unauthorized person without the prior written consent of IPS Architects.


Do not scale from this drawing.

All dimensions are to be checked on site prior to construction, manufacture of any components and ordering of materials and equipment.


Any discrepancies are to be reported to the architects for clarification.

All materials and workmanship to be accordance with the current British Standards and codes of practice.

This drawing is to be read in conjunction with all relevant Architectural Structural Engineers, Mechanical Engineers, Electrical Engineers and Specialists drawings and specifications.

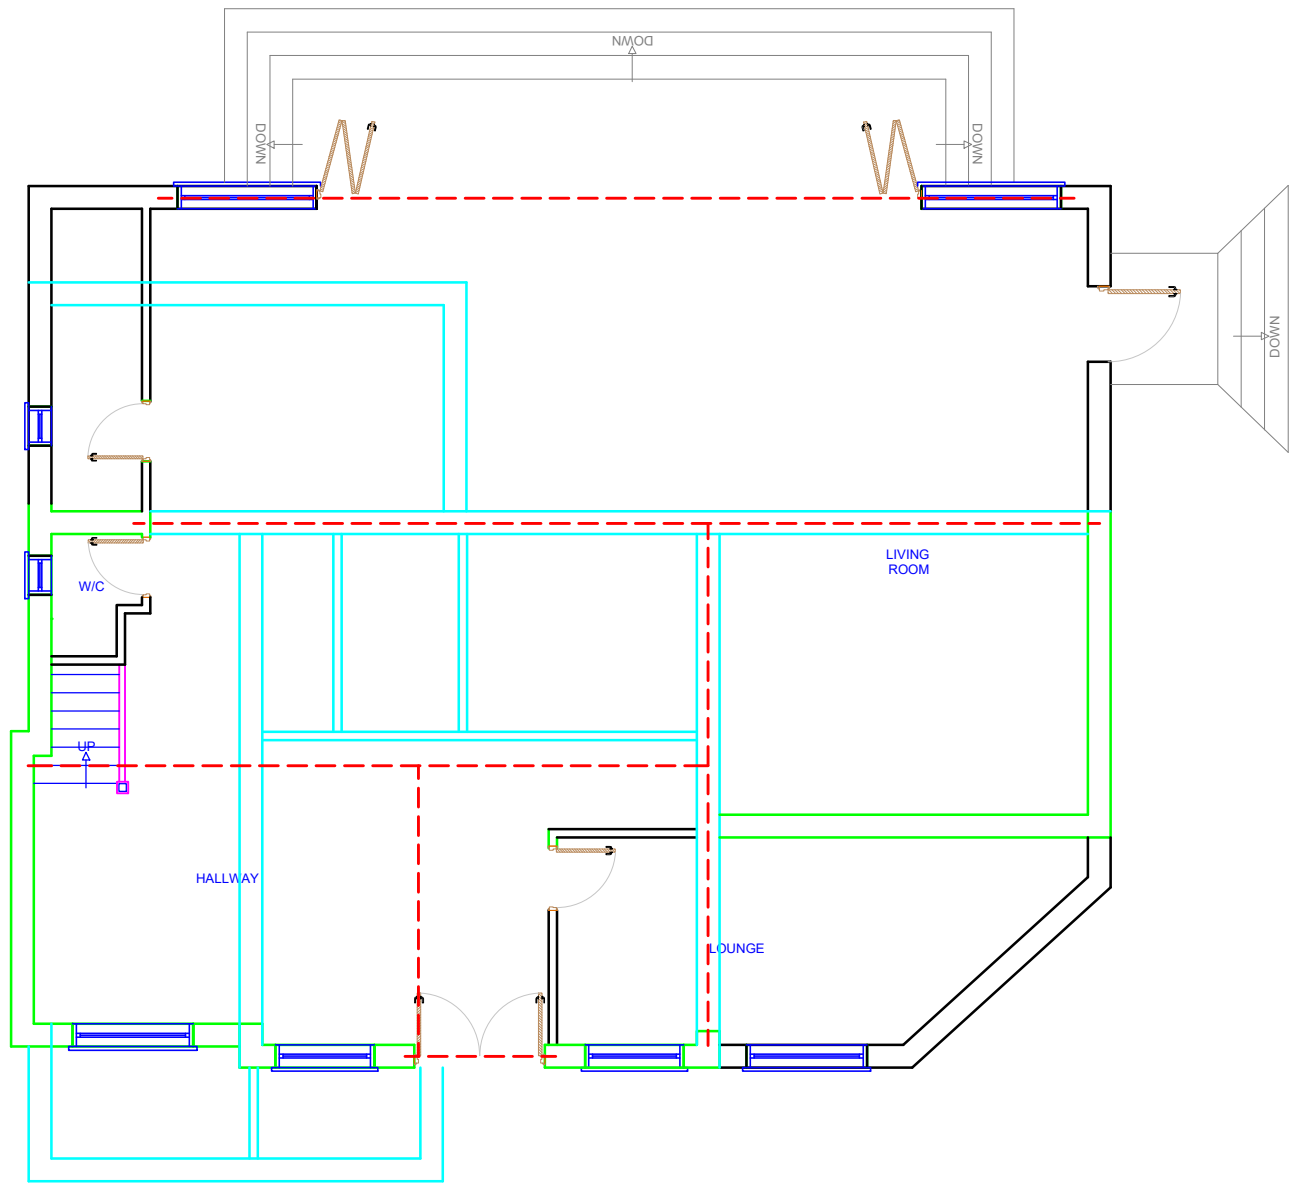

PROPOSED GROUND FLOOR PLAN
with the information of walls to be demolished in Cyan colour,
and information of structural support in Red dashed colour

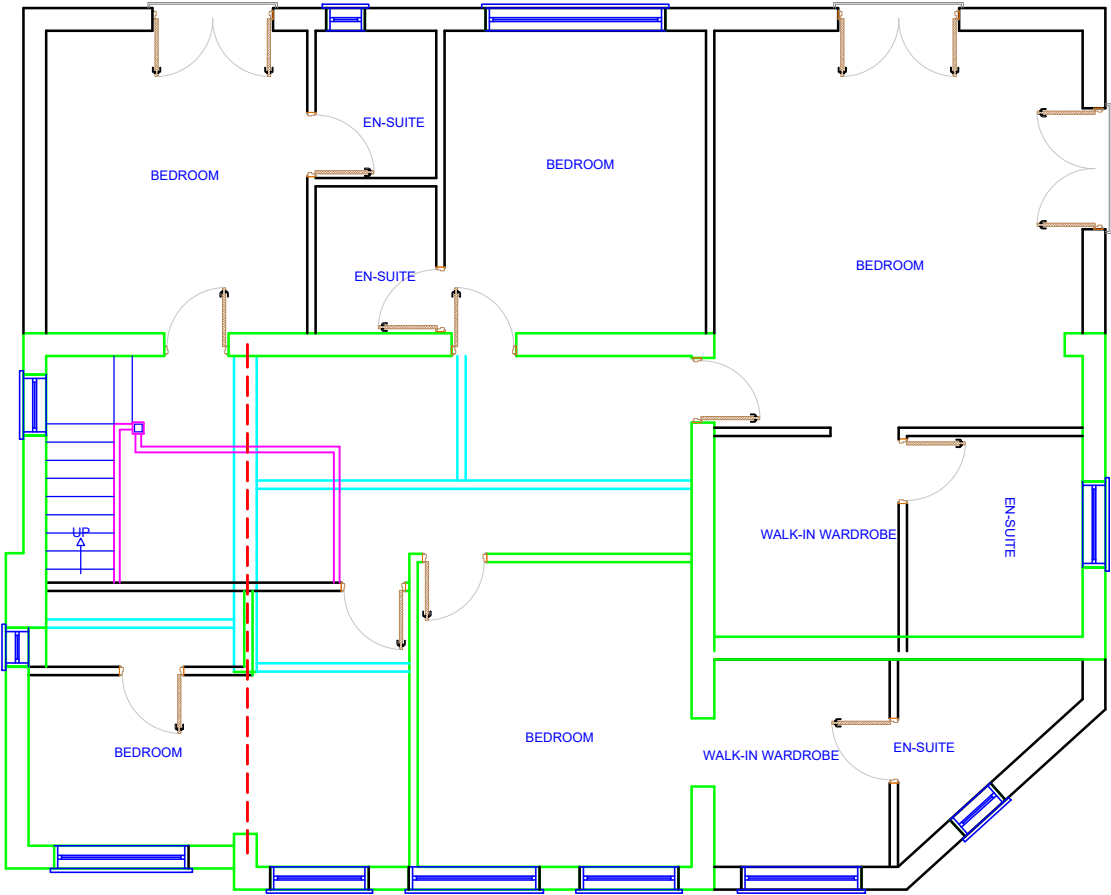

PROPOSED FIRST FLOOR PLAN
with the information of walls to be demolished in Cyan colour,
and information of structural support in Red dashed colour

Planning Services

email: ipsuk@live.co.uk

2A Cook Street,
Bury, Lancashire,
BL9 0RP,
0161 8717405

Demolition explanation on Floor plans
of 16 Turton Close, Bury, BL8 2EE

Scale :1 : 100 on A3

All Dimensions in Meters

Ref.: IPS/R/16/BL82EE

Date : 24/10/2022

SHT 7 of 8

Proposal

- Cyan colour lines indicates the walls to be removed
- Red dashed lines indicates steel beams to support existing and proposed structure
- Green lines indicates existing walls which will remain
- Black lines indicates proposed new walls

Statement of demolition

Walls showing in Cyan to be removed and the structure above these walls to be supported by steel beams.

Dashed red line indicate steel structure system to support remaining structure above

Green line indicate the remaining structure of existing building

Black lines are proposed extension walls,

*All walls going to be demolished to be supported/replaced by a steel structure system to keep the exiting building in place,

