


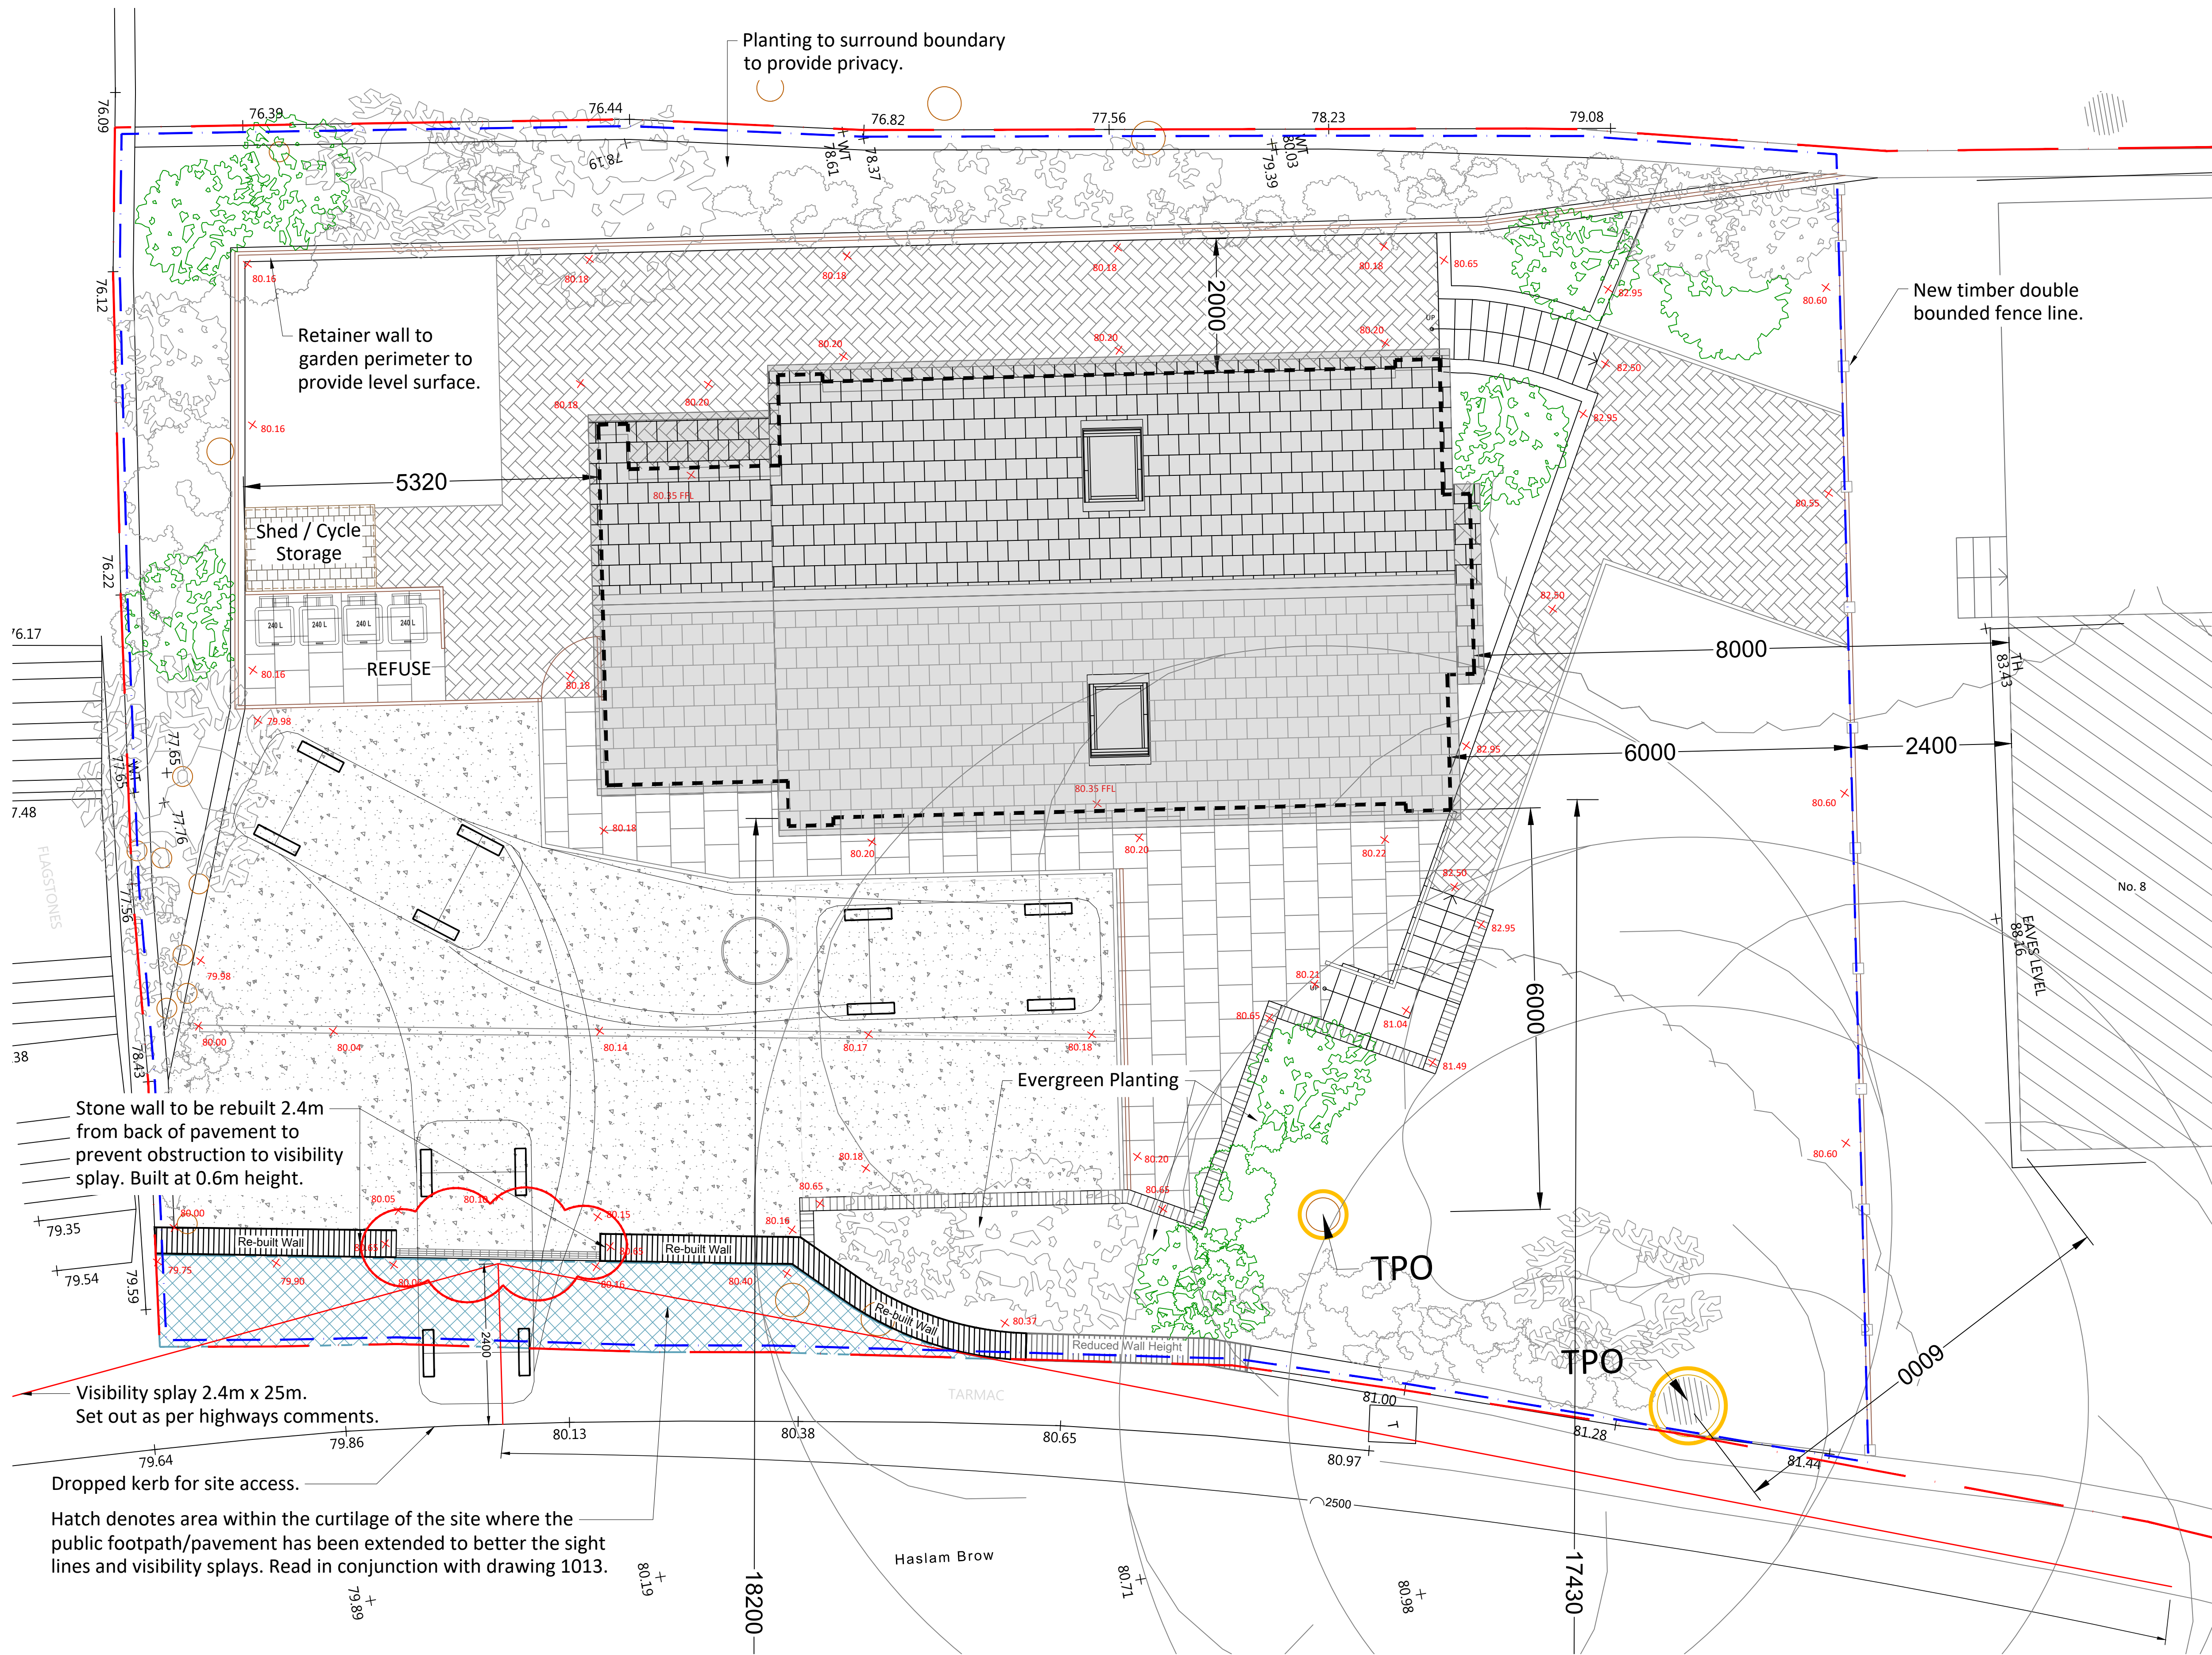

© This Drawing & Design is the copyright of Jenkins Design Services Ltd and should not be reproduced without written consent.

Contractors are to check all levels & dimensions on site prior to site works commencing & report discrepancies to the Designers.

DO NOT SCALE FROM THIS DRAWING

PLANNING

NOTES:-

Site boundary denoted with red line — equates to:-

934 m² / 0.0934 Hectares / 0.2308 Acres

Site area [TBD] denoted with blue line — equates to:-

480 m² / 0.048 Hectares / 0.1186 Acres

Key:-

× 80.31 Proposed Levels

× 80.31 Existing Levels

○ Tree Protection Order

C Minor amendments made following discussions with Planners. This includes driveway access gates omitted and windows on the western elevation reworked. CM TR 06.01.23

B Building Plan layout revised based upon topo and check survey on site. TR CM 12.09.22

A Site plan updated following topo survey. CM TR 15.08.22

Rev Description By Chk Date

Project: **Haslam Brow**
Wells Street, Bury

Title: External works extents including Highways

Client: LAL Shaheen Developments

Drawn By: CM Checked By: TR on 21/05/21

Original Size: A1 Project Number: 22065

Drawing Number: **SI-00-DR-A-1020** REV **C**

