

© This Drawing & Design is the copyright of Jenkins Design Services Ltd and should not be reproduced without written consent.

Contractors are to check all levels & dimensions on site prior to site works commencing & report discrepancies to the Designers.

DO NOT SCALE FROM THIS DRAWING

PLANNING


NOTES:-

Site boundary denoted with red line — — equates to:-
934 m² / 0.0934 Hectares / 0.2308 Acres

Site area [TBD] denoted with blue line — — equates to:-
480 m² / 0.048 Hectares / 0.1186 Acres

Key:-

- × 80.31 Proposed Levels
- × 80.31 Existing Levels
- Tree Protection Order

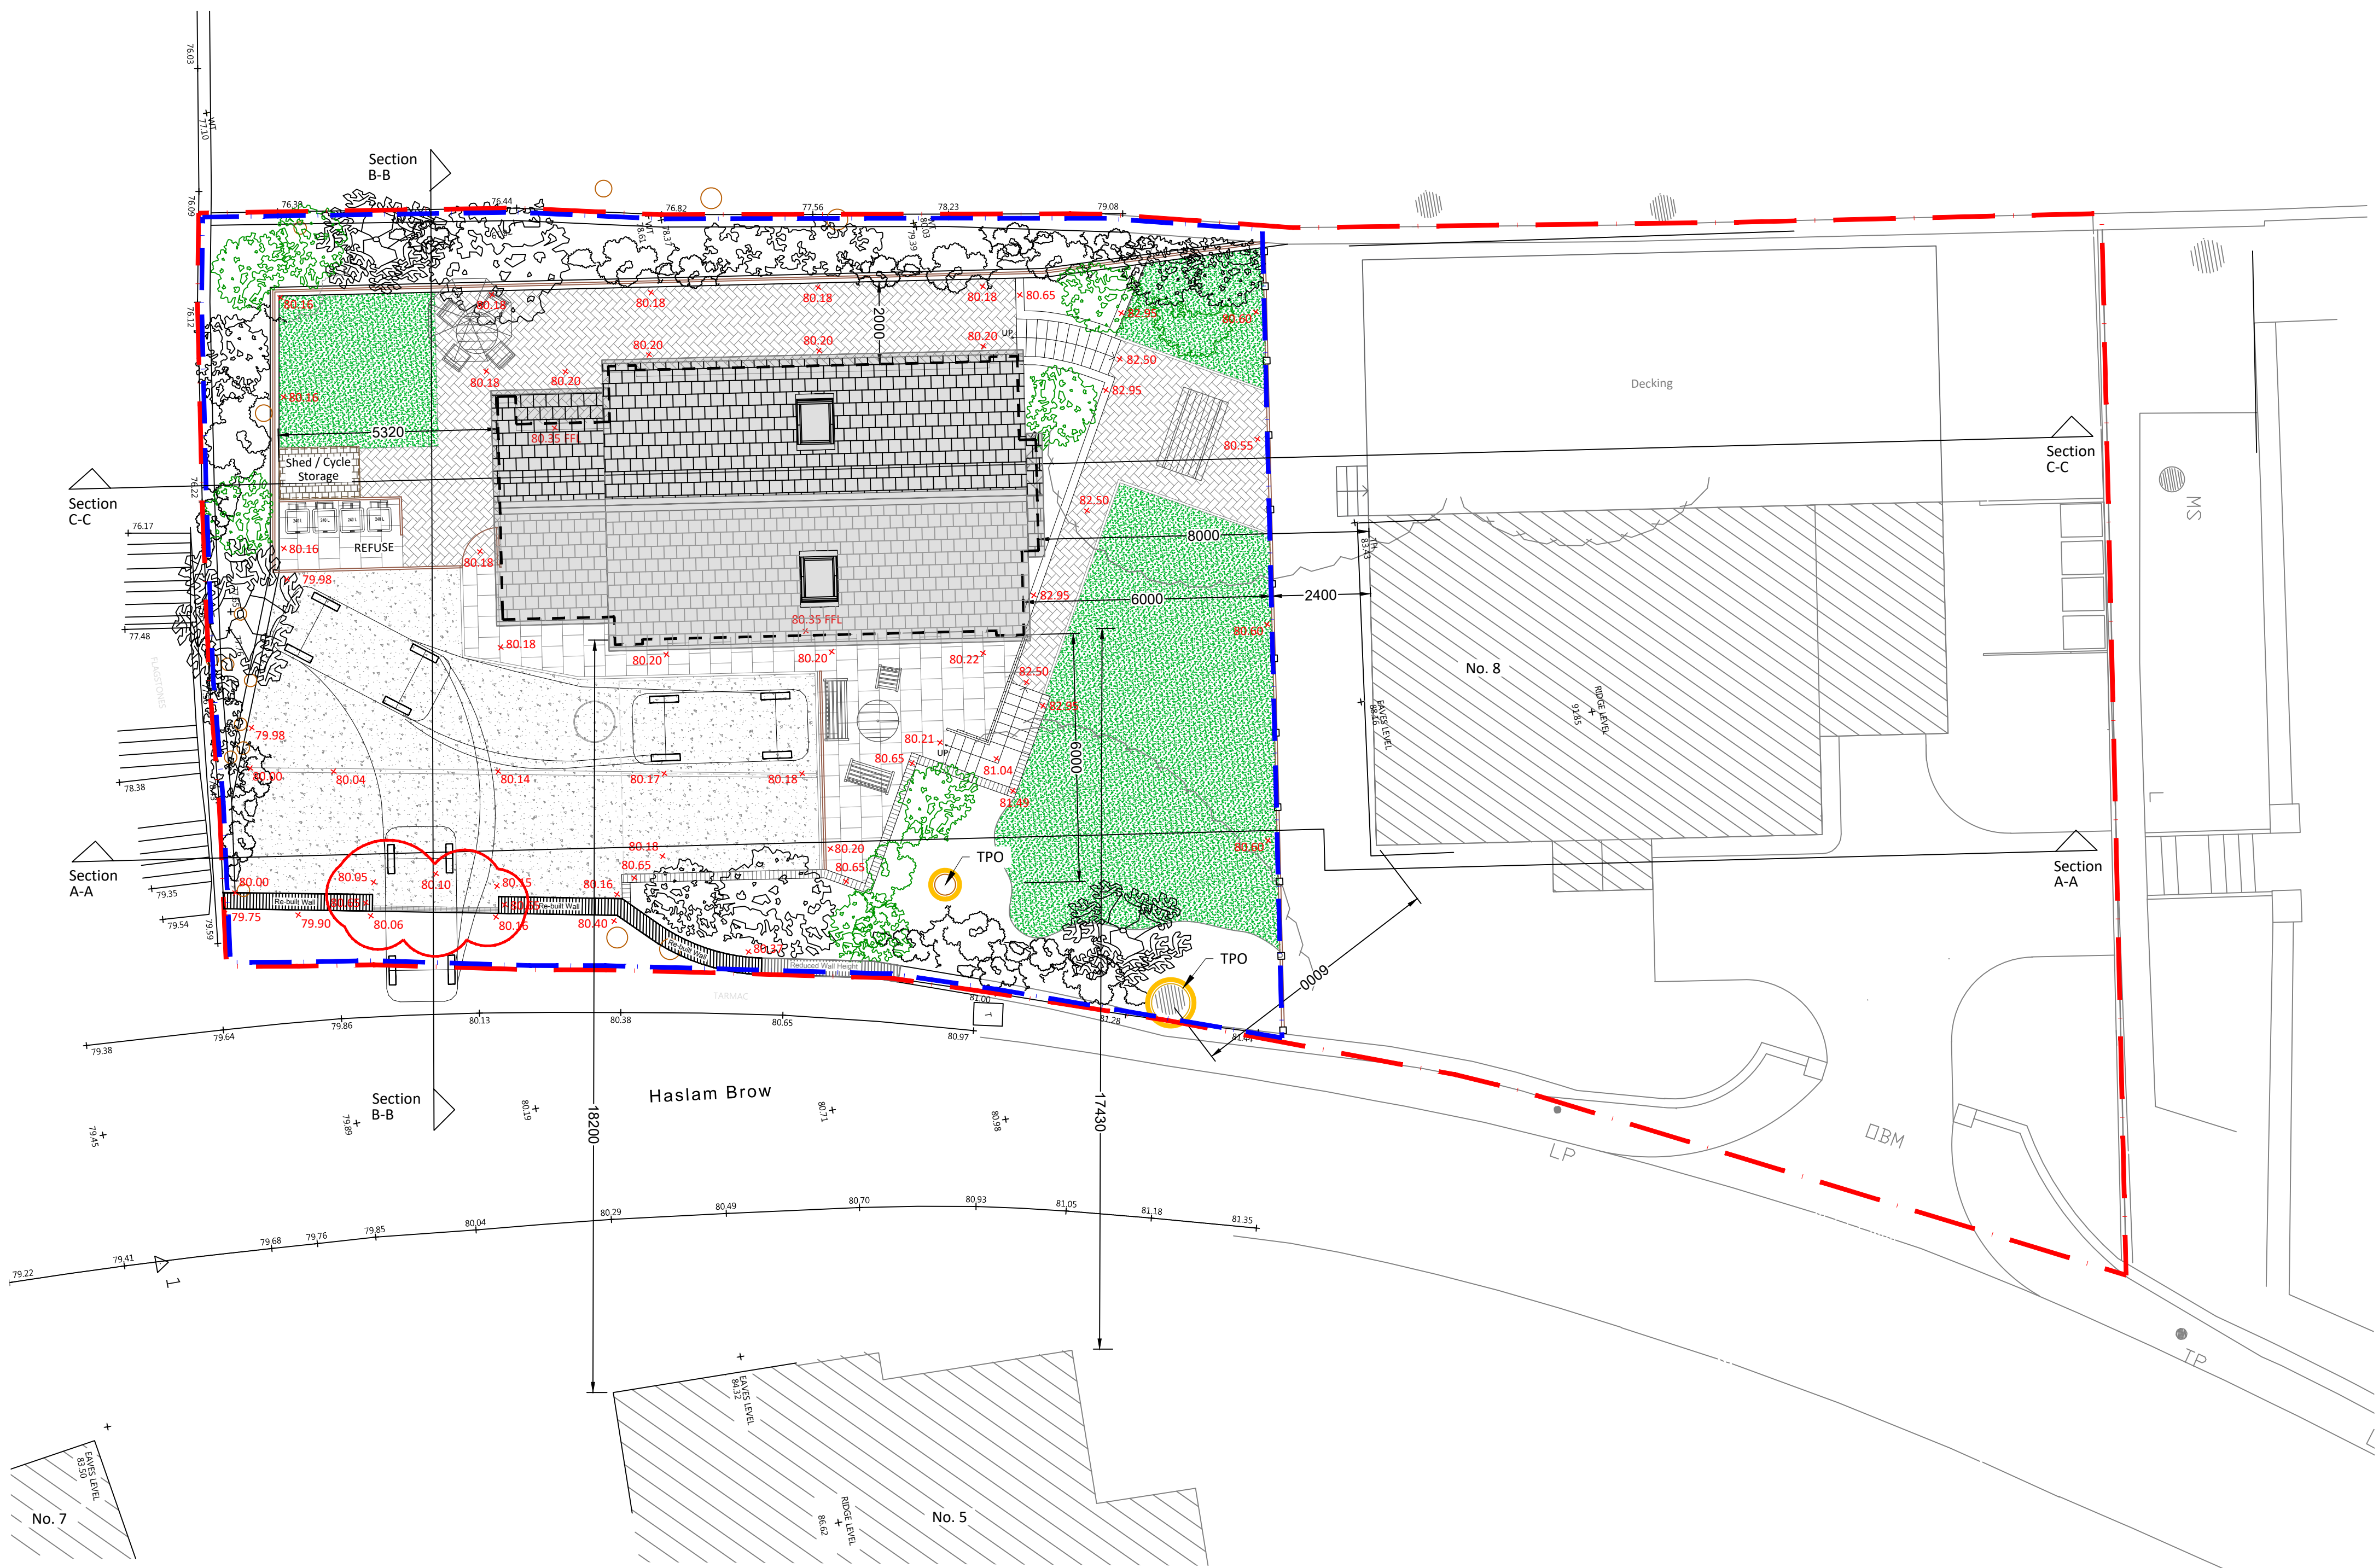

E	Minor amendments made following discussions with Planners. This includes driveway access gates omitted and windows on the western elevation reworked.	CM	TR	06.01.23
D	Building Plan layout revised based upon topo and check survey on site.	TR	CM	12.09.22
C	Site plan updated following topo survey.	CM	TR	15.08.22
B	Updates to align with Planning control comments	CM	TR	10.08.21
A	Vehicle tracking amended.	CM	TR	03.06.21
Rev	Description	By	Chk	Date

Project:	Haslam Brow Wells Street, Bury		
Title:	Proposed Site Layout		
Client:	LAL Shaheen Developments		
Drawn By:	CM	Checked By:	TR on 21/05/21
Original Size:	A1	Project Number:	22065
Drawing Number:	SI-00-DR-A-1011		REV E

