





1 - 01 - Existing Site Plan
1:200

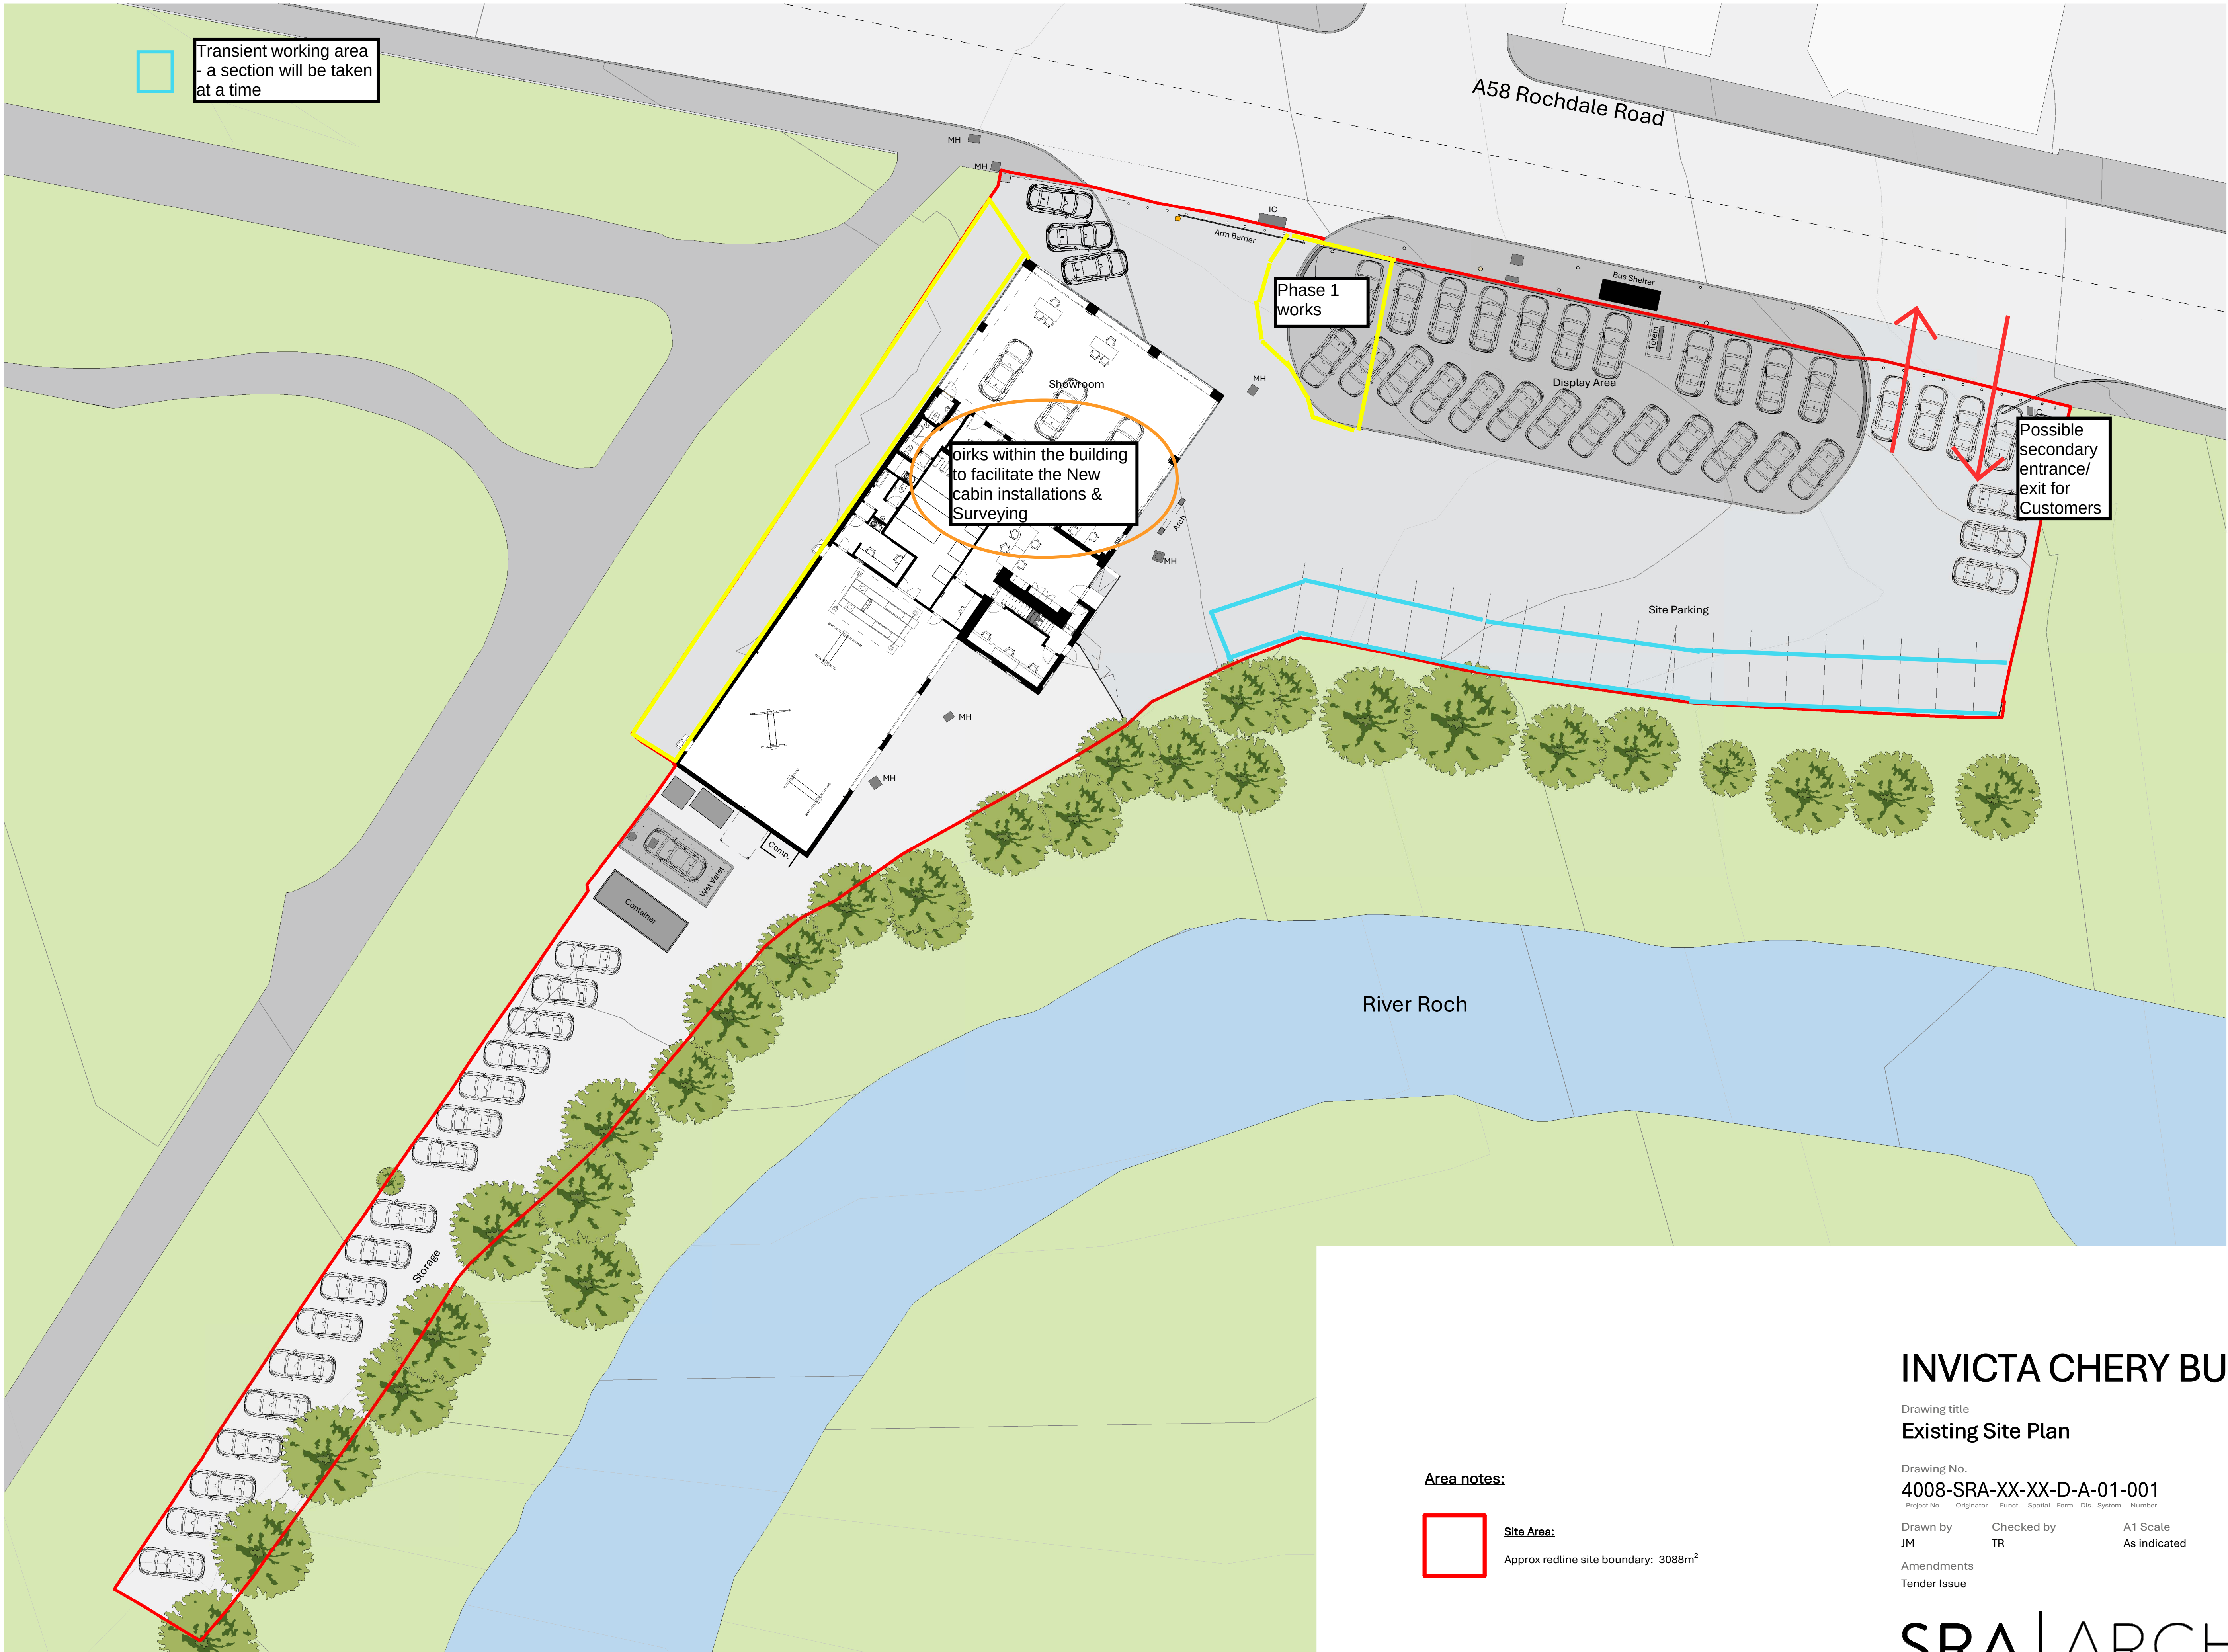

Area notes:

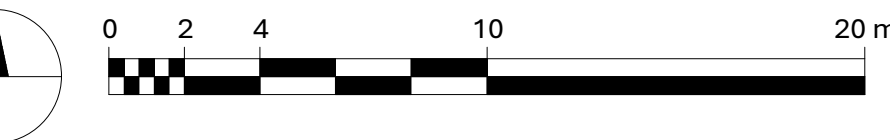

Site Area:
Approx redline site boundary: 3088m²

INVICTA CHERY BURY

Drawing title
Existing Site Plan

Drawing No.
4008-SRA-XX-XX-D-A-01-001

Project No. Originator Funct. Spatial Form Dis. System Number
JM TR As indicated

Amendments
Tender Issue

Revision
T01

Date
27/03/2026
15:41:40

Reason for Issue
Tender

SRA | ARCHITECTS

SRA Architects Ltd accepts no liability for use of this drawing by parties other than the party for whom it was prepared, or for purposes other than those for which it was prepared. When the above drawing is issued in DWG format it is an uncontrolled version issued to enable the recipient to prepare their own documents/ models/drawings for which they are solely responsible. It is based on background information current at the time of issue. SRA Architects Ltd accepts no liability for any such alterations or additions to or discrepancies arising out of changes to such background information which occur to that information after it is issued by SRA Architects Ltd. Responsibility is not accepted for errors made by others in scaling from this drawing. © (UK 2026) SRA Architects Ltd. SRA Architects Ltd, Station House, Ashley Avenue, Bath, BA1 3DS | sra-architects.co.uk | Registered in England and Wales 14336944