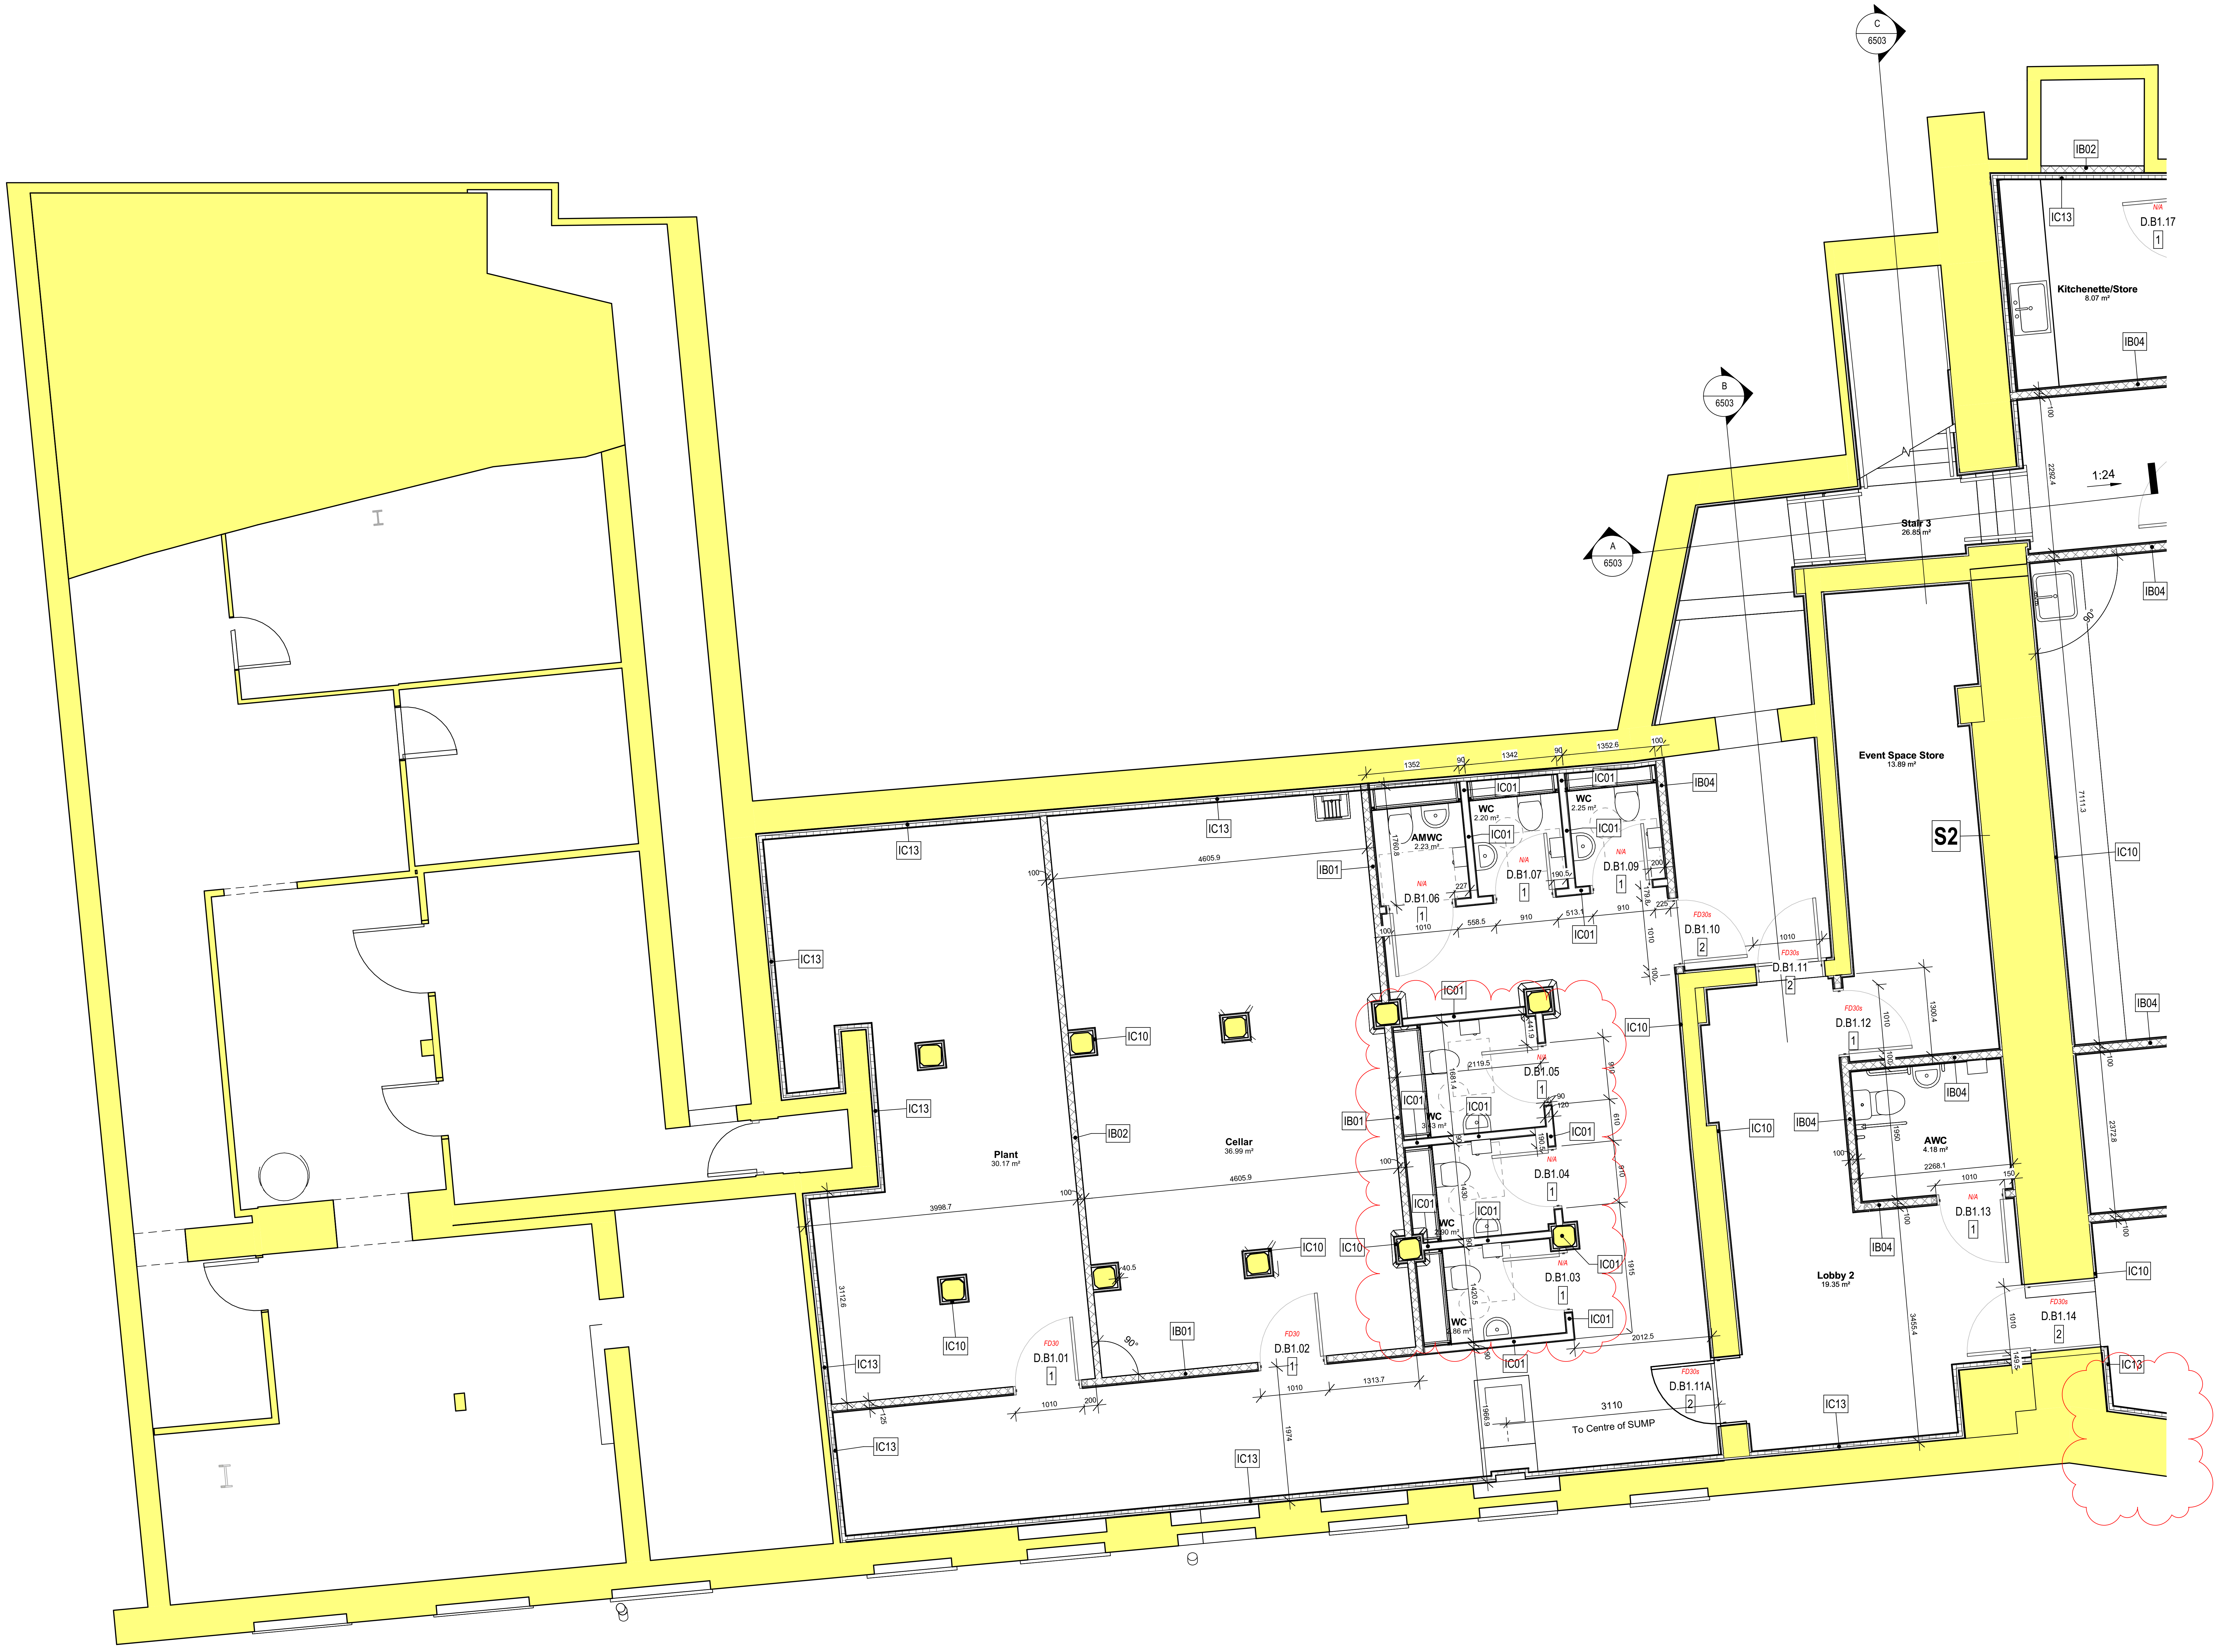

Level B1_Setting-out - Dependent 1

1 : 50

Notes

The Contractor is to check all dimensions and conditions on site before commencing. Do not scale from this drawing.
This drawing remains the copyright of POZZONI Architecture ltd.

Scale Bars TO BE USED ONLY AS GUIDANCE

1:5	mm		50		150		250
1:10	mm		100		300		500
1:20	mm		500		800		
1:50	mm		500		1500		2500

Rev	Description	By	Date
C01	Balcony omitted; WC layout amended to accommodate drainage. Construction Issue	MBR	23.02.24
P01	Stage 4 issue.	DY	26.05.23

Client	Vinci Construction UK Ltd				
Job	Radcliffe Market Chambers & Basement				
Drawing	Setting Out Plan Level B1 (sheet 1 of 2)				
POZ Ref.	P5860_2110	Rev	C01		
BS.Ref	RADHUB-POZ-ZZ-B1-DR-A-2110				
Date	04/01/23	Scale	1 : 50	@ A1	
3D CoOrd	DM	Approved	TT	STATUS	S5
Project Status	Planning	Tender		▶ Construction	
	Design	Contract		Construction Record	

pozzoni

Woodville House
2 Woodville Road
Altrincham
WA14 2FH

+44 161 928 7848
www.pozzoni.co.uk
architects@pozzoni.co.uk

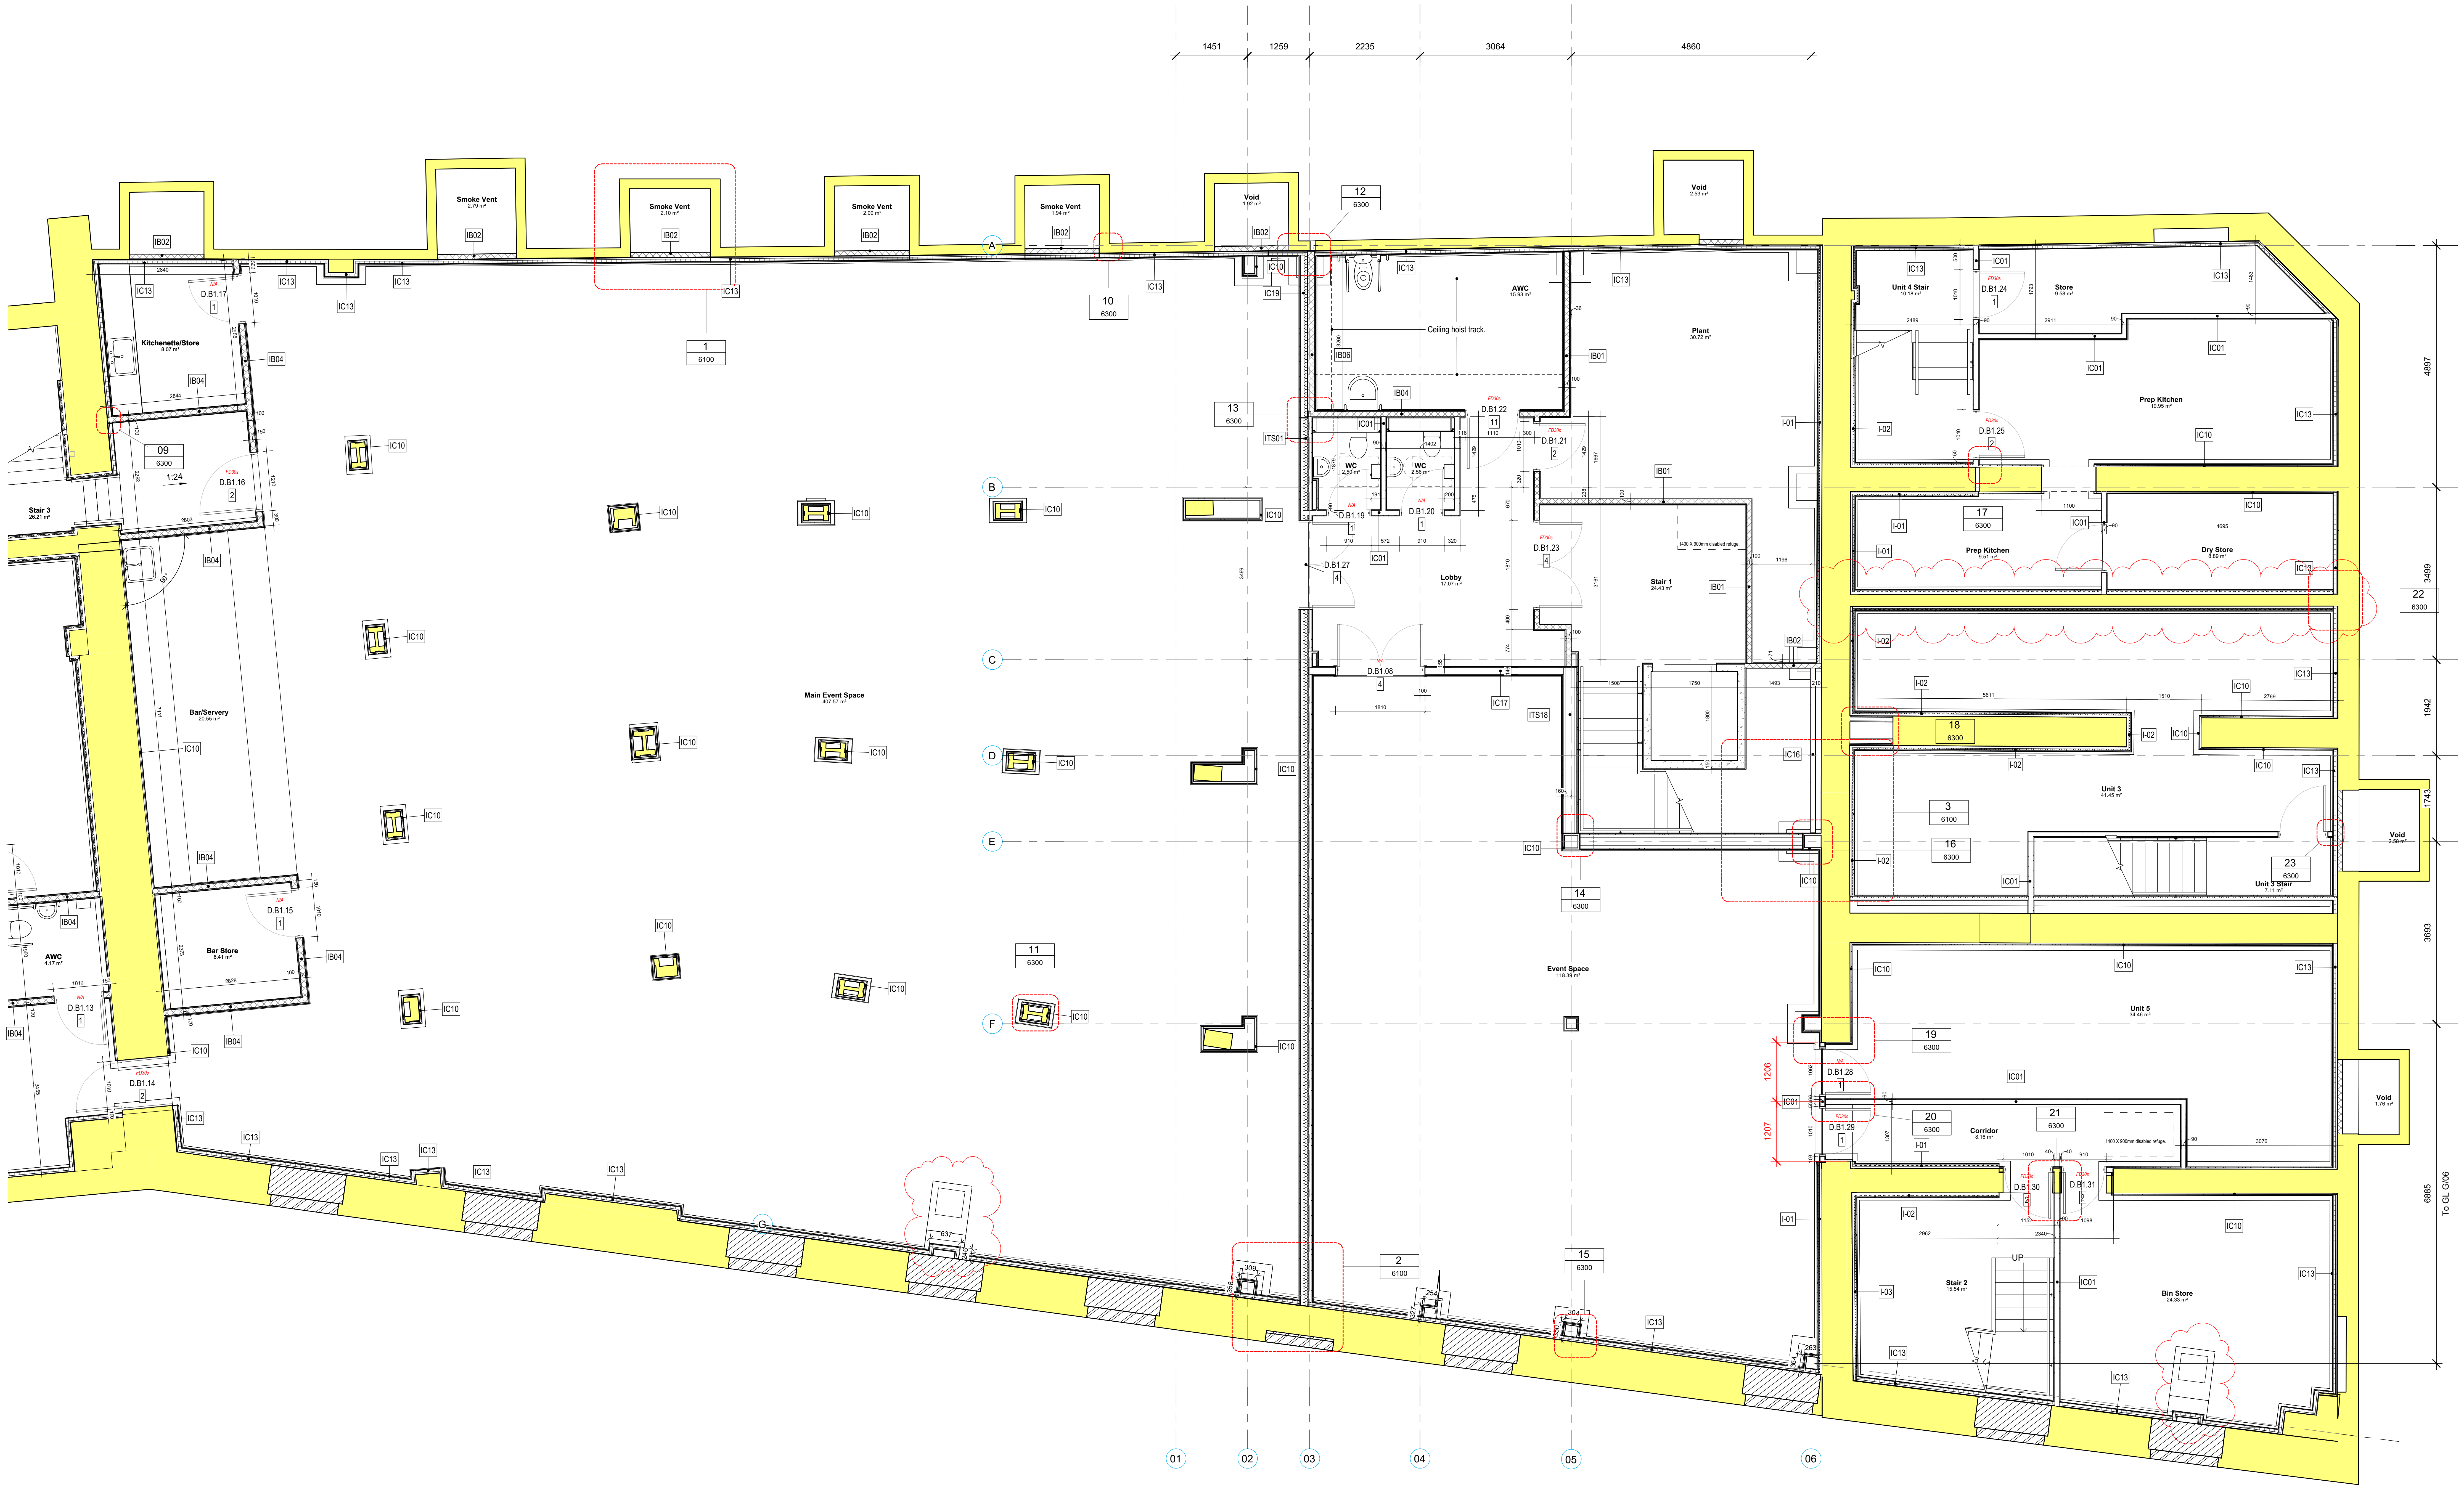

Level B1_Setting-out - Dependent 2
1 : 50

Notes

The Contractor is to check all dimensions and conditions on site before commencing. Do not scale from this drawing.
This drawing remains the copyright of POZZONI Architecture ltd.

Scale Bars TO BE USED ONLY AS GUIDANCE

1:5	mm	50	150	250
1:10	mm	100	300	500
1:20	mm	500	800	
1:50	mm	500	1500	2500

Rev	Description	By	Date
C02	Grid Lines reviewed and dimensions added	TT	07.11.24
C01	Sumps pumps added & wall lining amended to accommodate the drainage pipes; balcony omitted; wall lining added to conceal steelwork. Construction issue.	MBR	23.02.24
P01	Stage 4 issue.	DY	26.05.23

Client: Vinci Construction UK Ltd

Job: Radcliffe Market Chambers & Basement

Drawing: Setting Out Plan-Level B1 (sheet 2 of 2)

POZ Ref. P5860_2111 Rev C02

BS.Ref RADHUB-POZ-V2-B1-DR-A-2111

Date 04/01/23 Scale 1 : 50 @ A0

3D CoOrd WO Approved TT STATUS S5

Project Status: Planning, Tender, ▶ Construction, Design, Contract, Construction Record

pozzoni

Woodville House
2 Woodville Road
Altrincham
WA14 2FH

+44 161 928 7848
www.pozzoni.co.uk
architects@pozzoni.co.uk

Waterproofing Options Mark-Up. 16/10/24

🟥 - Option 2

🟦 - Option 1