
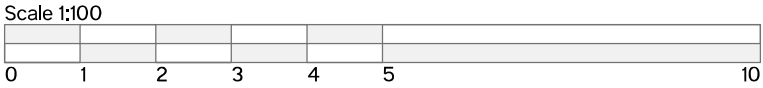


- Single door to become double french aluminium patio door
- Sliding door to change to french aluminium patio doors
- Glass lanterns have been replaced by flat roof light which sit lower than the parapet wall
- Patio doors to chnage to alumium french patio doors with side lights
- Stone gutter replaces all timber fascia boards

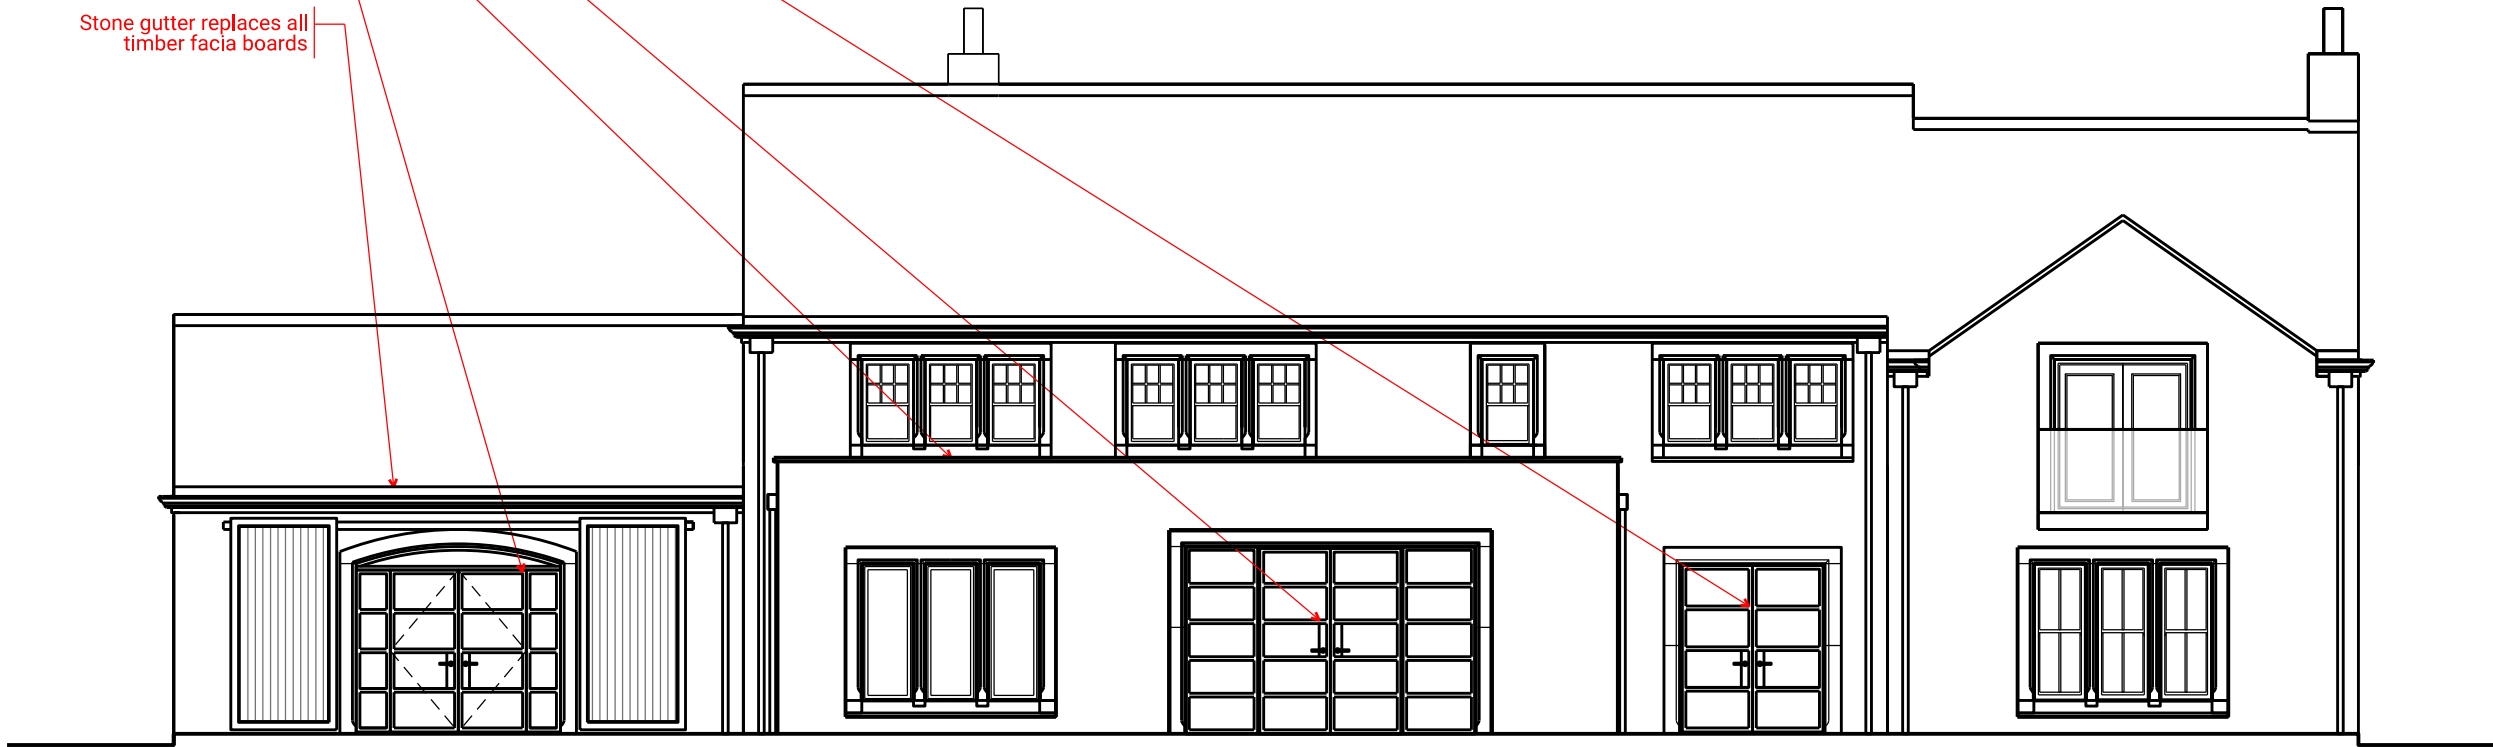

NORTHERN ARCHITECTS
11 Grosvenor Road
Altrincham
WA14 1LA
pg@northernarchitects.co.uk
+447799196215
www.northernarchitects.co.uk

Project
Ferns Farm
Tottington

Project No.
NA-2510

Revisions			
Rev	Description	By	Date

Notes:

Drawing Title
Rear (North) Elevation
as Proposed_Mark Up

Scale Date Status
1:100 @ A3 Sept 25 03

NA (-4) 021

This drawing is the exclusive copyright of Northern Architects Limited and remains under the ownership of the company. Reproduction, sharing, or copying of this drawing without prior written consent is strictly prohibited.
Adhere to all dimensions as indicated. It is essential to verify all dimensions on-site before proceeding with construction or manufacturing.